

LIGHTING FIXTURE SCHEDULE

FINISH TYPE	MANUFACTURER CATALOG NUMBER	(2) (3)	LAMPS			FEATURE	BALLAST TYPE (1)	MOUNTING	DESCRIPTION	
			QTY.	TYPE	WATTS					COLOR TEMP.
(B)	LIGHTOLIER	QV9-2-G-HF-LV-3-32-2T1-XX	3	T8 935XFP6	32	3500°K	2T1	T2	DIMMING CEILING RECESSED GRID	2'x4' LAT-IN FIXTURE PLAT BLADE LOWER WITH LENS OVERLAY AND PERFORATED CURVED SIDE BLADES 5 1/2" DEEP, ONE PIECE HOUSING WITH 3 LAMP 3% DIMMING BALLAST.
(BT)	LIGHTOLIER	QV9-2-G-HF-LV-3-32-2T1-XX	3	T8 F027/ 935XFP6	32	3500°K	2T1	T2	ELECTRONIC CEILING RECESSED GRID	2'x4' LAT-IN FIXTURE PLAT BLADE LOWER WITH LENS OVERLAY AND PERFORATED CURVED SIDE BLADES 5 1/2" DEEP, ONE PIECE HOUSING, ONE T1 AND ONE SINGLE LAMP BALLAST.
(BT)	LIGHTOLIER	QV9-2-G-HF-LV-3-32-2T1-XX	3	T8 935XFP6	32	3500°K	2T1	T2	ELECTRONIC CEILING RECESSED GRID	SAME AS TYPE 'BI' EXCEPT TANDEM WIRED.
(BE)	LIGHTOLIER	QV9-2-G-HF-LV-3-32-2T1-XX-N	3	F027/ 935XFP6	32	3500°K	2T1	T2	ELECTRONIC CEILING RECESSED GRID	SAME AS TYPE 'BI' EXCEPT WITH BODINE B3209T EMERGENCY BALLAST.
(D)	LIGHTOLIER	SH46-232-HFF-2T1-AUG3BU-CSP	2	T8 935XFP6	32	3500°K	2T1	4S	ELECTRONIC SURFACE/ CHAIN HANG	4' STRIP LIGHT WITH WIRE GUARD.
(G)	LIGHTOLIER	9P9-F8-F9-VA-2-32-2T1	2	F027/ 935XFP6	92	3500K	2T1	4S	ELECTRONIC CEILING RECESSED FLANGE	1'x4' RECESSED MOUNTED FLUORESCENT FIXTURE WITH Ø129" MINIMUM THICKNESS ARTISTIC LENS COMPLETE WITH MOUNTING HARDWARE FOR STAY-BOND CEILING.
(H)	KELIN F86-10-14-60 NO SUBSTITUTIONS	F86-10-14-60 NO SUBSTITUTIONS	2	TRIPLE TUBE CF	42	5500K	120/2T1	90	ELECTRONIC SURFACE	10" SQUARE SURFACE DOWNLIGHT WITH GLASS LENS AND UET LOCATION LISTING. FIXTURE TO MATCH EXISTING. NOTE: FINISHES FURNISHED BY OWNER AND INSTALLED BY ELECTRICAL CONTRACTOR.
(E)	PRESCOLITE CF9324EB-SIT502H	CF9324EB-SIT502H	2	QUAD TUBE CF	26	3500°K	2T1	54	ELECTRONIC CEILING RECESSED	6" DOWNLIGHT WITH HORIZONTAL LAMPS AND CLEAR ALZAK REFLECTOR
(J)	PRESCOLITE CF9324EB-SIT502H	CF9324EB-SIT502H	2	TRIPLE TUBE CF	42	3500K	2T1	90	ELECTRONIC CEILING RECESSED	9" DOWNLIGHT WITH HORIZONTALLY MOUNTED LAMPS AND SPECULAR REFLECTOR
(JE)	PRESCOLITE CF9324EB-SIT502H	CF9324EB-SIT502H	2	TRIPLE TUBE CF	42	3500K	2T1	90	ELECTRONIC CEILING RECESSED	9" DOWNLIGHT WITH HORIZONTALLY MOUNTED LAMPS AND SPECULAR REFLECTOR COMPLETE WITH EMERGENCY BATTERY PACK WITH TEST SWITCH AND LAMP FURNISH WITH DIMMING BALLAST TO 3%.
(JF)	PRESCOLITE CF9324EB-DI1-SIT502H	CF9324EB-DI1-SIT502H	2	TRIPLE TUBE CF	42	3500K	2T1	90	DIMMING CEILING RECESSED	9" DOWNLIGHT WITH HORIZONTALLY MOUNTED LAMPS AND SPECULAR REFLECTOR COMPLETE WITH DIMMING BALLAST TO 3%.
(K)	DUALITE LE-G-N-EI	-	-	LED	4.4	-	120/2T1	4.4	SEMI- RECESSED/ WALL	LED EDGE LIT EXIT SIGN WITH FACIES, MOUNTING AND AREOUS AS REQUIRED PER DRAWINGS, SELF-TESTING.
(Q)	LIGHTOLIER 6N4-SI-32-HFF-2T1	6N4-SI-32-HFF-2T1	1	T8	32	N/A	2T1	25	ELECTRONIC SURFACE	4'-0" NARROW STRIP LIGHT FOR SURFACE MOUNTING.
(O)	KIM KIGHTING IA-ARB-236H-FST1-DB-P	IA-ARB-236H-FST1-DB-P	1	HFS	250	4000°K	2T1	333	CWA POLE ARM	250 WATT HIGH PRESSURE SODIUM PARKING LOT LIGHTING FIXTURE. IN DISMOUNT POSITION PROVIDE MATCHING 120 FOOT SQUARE STRAIGHT ALUMINUM POLE LUMINAIRE AND POLE TO BE BRONZE IN COLOR.
(P)	LITHONIA TUL-509-2T1-HF-XHP-TULLUS	TUL-509-2T1-HF-XHP-TULLUS	1	HFS	50	4000°K	2T1	13	ELECTRONIC WALL	WALL MOUNTED EXTERIOR LIGHT WITH BUILT-IN PHOTOCEL. FURNISH WITH UNREGUARD MOUNT AT 8'-0" AFF.
(U)	SELUX CORP (2) LUD-8-1-HTB-BX-2T1 WITH STEEL POLE #95-10-BS-BC3 NO SUBSTITUTIONS	LUD-8-1-HTB-BX-2T1 WITH STEEL POLE #95-10-BS-BC3 NO SUBSTITUTIONS	1	M4	1TB	4000°K	2T1	216	CWA POLE TOP	TB WATT METAL HALIDE PATHWAY LIGHTING FIXTURE, DIE-CAST ALUMINUM. 8' CYLINDER MOUNT. 1/2" DIA. ENTER 10 FOOT STRAIGHT POLE. LUMINAIRE AND POLE TO BE BRONZE IN COLOR. FIXTURE TO MATCH EXISTING. NOTE: ONE FIXTURE FURNISHED BY OWNER AND INSTALLED BY ELECTRICAL CONTRACTOR.
(V)	VIBA LIGHTING CEB142 24x40(120V) BA RST	CEB142 24x40(120V) BA RST	1	T10	40	-	100	40	N/A WALL	40 WATT DECORATIVE WALL SCONCE WITH WHITE URASP ABS COVER. COORDINATE WITH BRUSHED ALUMINUM. FINISH COLOR TO BE BRUSHED ALUMINUM. MOUNT AT 6'-4" AFF. COORDINATE WITH ARCHITECTURAL ELEVATIONS.
(W)	HALO LB85-P FIXTURE WITH LA3-I-P TRACK	LB85-P FIXTURE WITH LA3-I-P TRACK	1	PAR38 SPOT	150	N/A	100	150	N/A 4'-0" TRACK	INCANDESCENT ROUNDBACK SPOT LIGHT. FIXTURES TO BE MOUNTED DIRECTLY TO 4'-0" SINGLE CIRCUIT TRACK WHITE FINISH.
(X)	FEACHTREE LIGHTING PCT-632-P-DIM-524-K 3 SOCKET	FEACHTREE LIGHTING PCT-632-P-DIM-524-K 3 SOCKET	1	QUAD TUBE CF	32	3500°K	2T1	99	ELECTRONIC PENDANT	PENDANT MOUNTED 6" CYLINDER FIXTURE. MOUNT BOTTOM OF FIXTURE FLUSH WITH GRID CEILING. FURNISH BRUNEL CANOPY AND 91ETI PENDANT LENGTH AS REQUIRED. FINISH TO BE BLACK.

REFER TO SPECIFICATIONS FOR ADDITIONAL REQUIREMENTS AND FOR SUBSTITUTION PROCEDURE.

FIXTURE GENERAL NOTES

1. PROVIDE SWAY BRACING FOR EVERY PENDANT OR CABLE MOUNTED FIXTURE THAT CANNOT SUING 45° IN EVERY DIRECTION WITHOUT CONTACTING AN OBSTRUCTION. PROVIDE SAFETY WIRE OR CABLE ATTACHED TO FIXTURE AND STRUCTURE AT EACH SUPPORT. CAPABLE OF SUPPORTING FOUR TIMES THE SUPPORTED LOAD. SWAY BRACING SHALL CONFORM TO ALL REQUIREMENTS OF TABLE 16A-C, 2020 C.B.C.

FIXTURE KEYED NOTES

- ① FIXTURE CONNECTION SHALL BE AS INDICATED ON THE PLANS AND SHALL COMPLY WITH THE APPLICABLE EFFICIENCY REGULATIONS, AND REQUIREMENTS OF TITLE 24, CALIFORNIA ENERGY CODE.
- ② OR EQUIVALENT IF APPROVED BY SCHOOL DISTRICT AND ENGINEER.
- ③ CATALOG NUMBERS ARE BASED ON VENDOR INFORMATION. THESE LITERATURE AND PHOTOGRAPHIC DATA ON HAND AT THE TIME OF THE BIDDING PROCESS SHALL BE USED AND INTENDED TO CONVEY THE FEATURES/PERFORMANCE ARE INTENDED. EACH FIXTURE MUST BE PROVIDED COMPLETE WITH ALL FITTINGS AS APPROPRIATE FOR PROPER MOUNTING AT THE LOCATION INDICATED.
- ④ MOUNTING SHALL INCLUDE CONCEALED SOLID BLOCKING FOR FIXTURES MOUNTED NEON WALLS AND HARD CEILINGS. AT SUSPENDED CEILING BEAMS WIRING SHALL BE INSTALLED IN COMPLIANCE WITH THE REQUIREMENTS OF THE CALIFORNIA BUILDING CODE (PART 2, TITLE 24).

EMERGENCY FIXTURE CONNECTIONS

ALL LIGHT FIXTURES WITH INTEGRAL BATTERY PACKS
REQUIRE PERMANENT UNATTACHED POWER TO ENSURE THE
BATTERY IS NEVER ALLOWED TO COMPLETELY DISCHARGE.
DO NOT CONNECT THESE FIXTURES TO TEMPORARY
BUILDING CONSTRUCTION POWER.
CONNECT ONLY TO PERMANENT BUILDING POWER WHEN
AVAILABLE, AND ACCORDING TO THE RESPECTIVE
MANUFACTURER'S RECOMMENDATIONS.

NOTE

ALL LAMPINGS SHOWN SPACES SHALL BE MANUFACTURED BY ORSANY/SYLVANIA, VENTURE, PHILIPS OR GE LINES. SPECIFICALLY NOTED OTHERWISE, WHERE AVAILABLE, ALL FLUORESCENT LAMPINGS SHALL BE OF THE TYPE THAT PERMITS NON-HAZARDOUS DISPOSAL. ALL LAMPINGS (INCLUDING SPACES) OF EACH TYPE, STYLE AND WATTAGE SHALL BE IDENTIFIED BY A SINGLE MANUFACTURING BATCH TO ENSURE PROPER REPLACEMENT. LAMPINGS WITH EXHAUSTED LIFE, LAMPINGS DIFFERING IN COLOR APPEARANCE WITH RESPECT TO COLOR TEMPERATURE SHALL BE REPLACED BY THE CONTRACTOR AT NO ADDITIONAL COST TO THE OWNER.

NOTE


ALL 4'-0" T8 LAMPS SHALL BE SPECIFICALLY SYLVANIA
XPS TYPE #0321835XP9/ECO WITH A CRI OF 86 (SUPER TB).
NO EXCEPTIONS WILL BE ALLOWED.

ALL NON-DIMED 4'-0" FIXTURES SHALL BE PROVIDED WITH THE FOLLOWING LAMP/BALLAST COMBINATIONS:

LAMPS: SYLVANIA FC32/835XP/ECO AND SYLVANIA BALLASTS AS FOLLOWS:

1 LAMP: • QTP1X32T8/UNV P9X F (25 WATTS)
2 LAMP: • QTP2X32T8/UNV P9X F (49 WATTS)
3 LAMP: • QTP3X32T8/UNV P9X F (72 WATTS)

THESE COMBINATIONS SHALL PROVIDE 30000 HOUR RATED LAMP LIFE TOGETHER WITH A LIMITED 36 MONTH LAMP WARRANTY AND AN ASSOCIATED 5 YEAR BALLAST WARRANTY. (REFER PENNSYLVANIA QUICK 60+ WARRANTY)

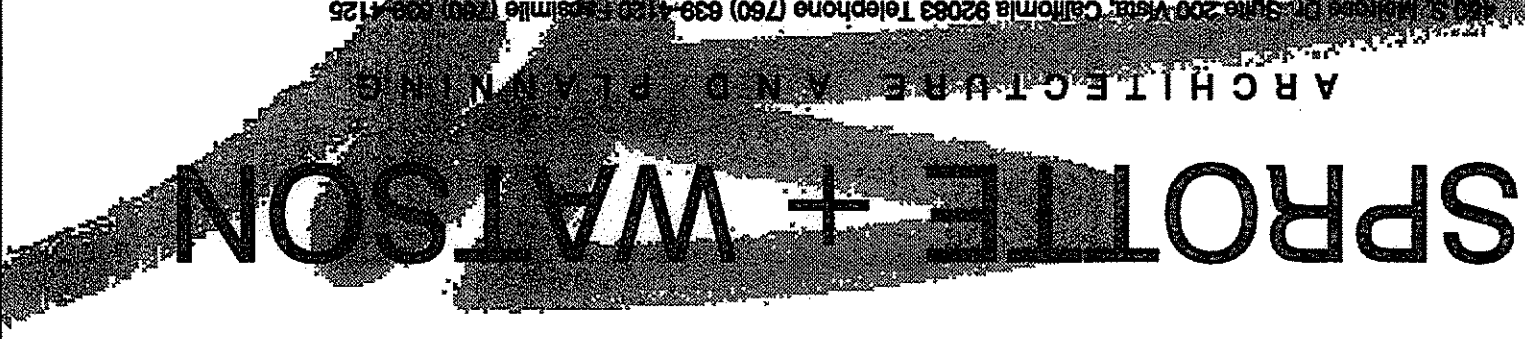

ADMINISTRATION BUILDING
CAJON VALLEY MIDDLE SCHOOL
395 BALLANTYNE ROAD,
EL CAJON, CALIFORNIA, 92020
CAJON VALLEY UNION SCHOOL DISTRICT

CONSULTANT

MORROW - MEADOWS CORP.
RECORD DRAWINGS
DATE: 1/26/98
SIGN: [Signature]

REVISIONS

APPROVALS

04 - 107941
C. - FLS. 114 88
DATE SEP 14 2006

LIGHTING FIXTURE SCHEDULE

DATE _____

09/12/06

JOB # 05365.00

0212_6

SHEET #

TURPIN & RATTAN
CONSULTING ELECTRICAL ENGINEERS
4719 PALM AVENUE
LA MECA, CA 91941-5521
P: (619) 441-1111
F: (619) 441-1112
E: ENGINEERS@TRR-CA.COM

PROFESSIONAL ENGINEER
STATE OF CALIFORNIA
No. 13554
EXPIRES 12/31/2008

NEW FORTE 8020
REG. NO. 08142

SPROTTE + WATSON
ARCHITECTS AND PLANNERS
400 S. BAYVIEW DRIVE, SUITE 200, VESLEY, CALIFORNIA 92083
TELEPHONE (760) 639-4100 FAX (760) 639-1725



ADMINISTRATION BUILDING
395 BALLANTYNE ROAD,
EL CAJON, CALIFORNIA, 92020
CAJON VALLEY UNION SCHOOL DISTRICT

CONSULTANT

MODIFIED: MIDDOWS CONIF
RECORD DRAWINGS
DATE: 1/16/08
SIGN: [Signature]

REVISIONS

APPROVALS
IDENTIFICATION STAMP
DIV. OF THE STATE ARCHITECT
OFFICE OF REGULATION SERVICES
04 - 107941
AC - FLS/11/88
DATE: SEP 14 2006

DESCRIPTION

ELECTRICAL
SHEET

DATE
09/12/06


JOB # 05365.00

0212_6

SHEET #

E-1.1

- NOTES**
1. PROVIDE NEW WIRING IN EXISTING CONDUITS
 2. RELOCATE BOGEN DISPLAY AND POWER RELOCATED IN RECEPTION ROOM (SEE E-23 FOR NEW LOCATION)
- SITE PLAN NOTE**
EXISTING WORK ON THIS PLAN IS INDICATED BY DASHED LINES, UNLESS SPECIFICALLY NOTED OTHERWISE.

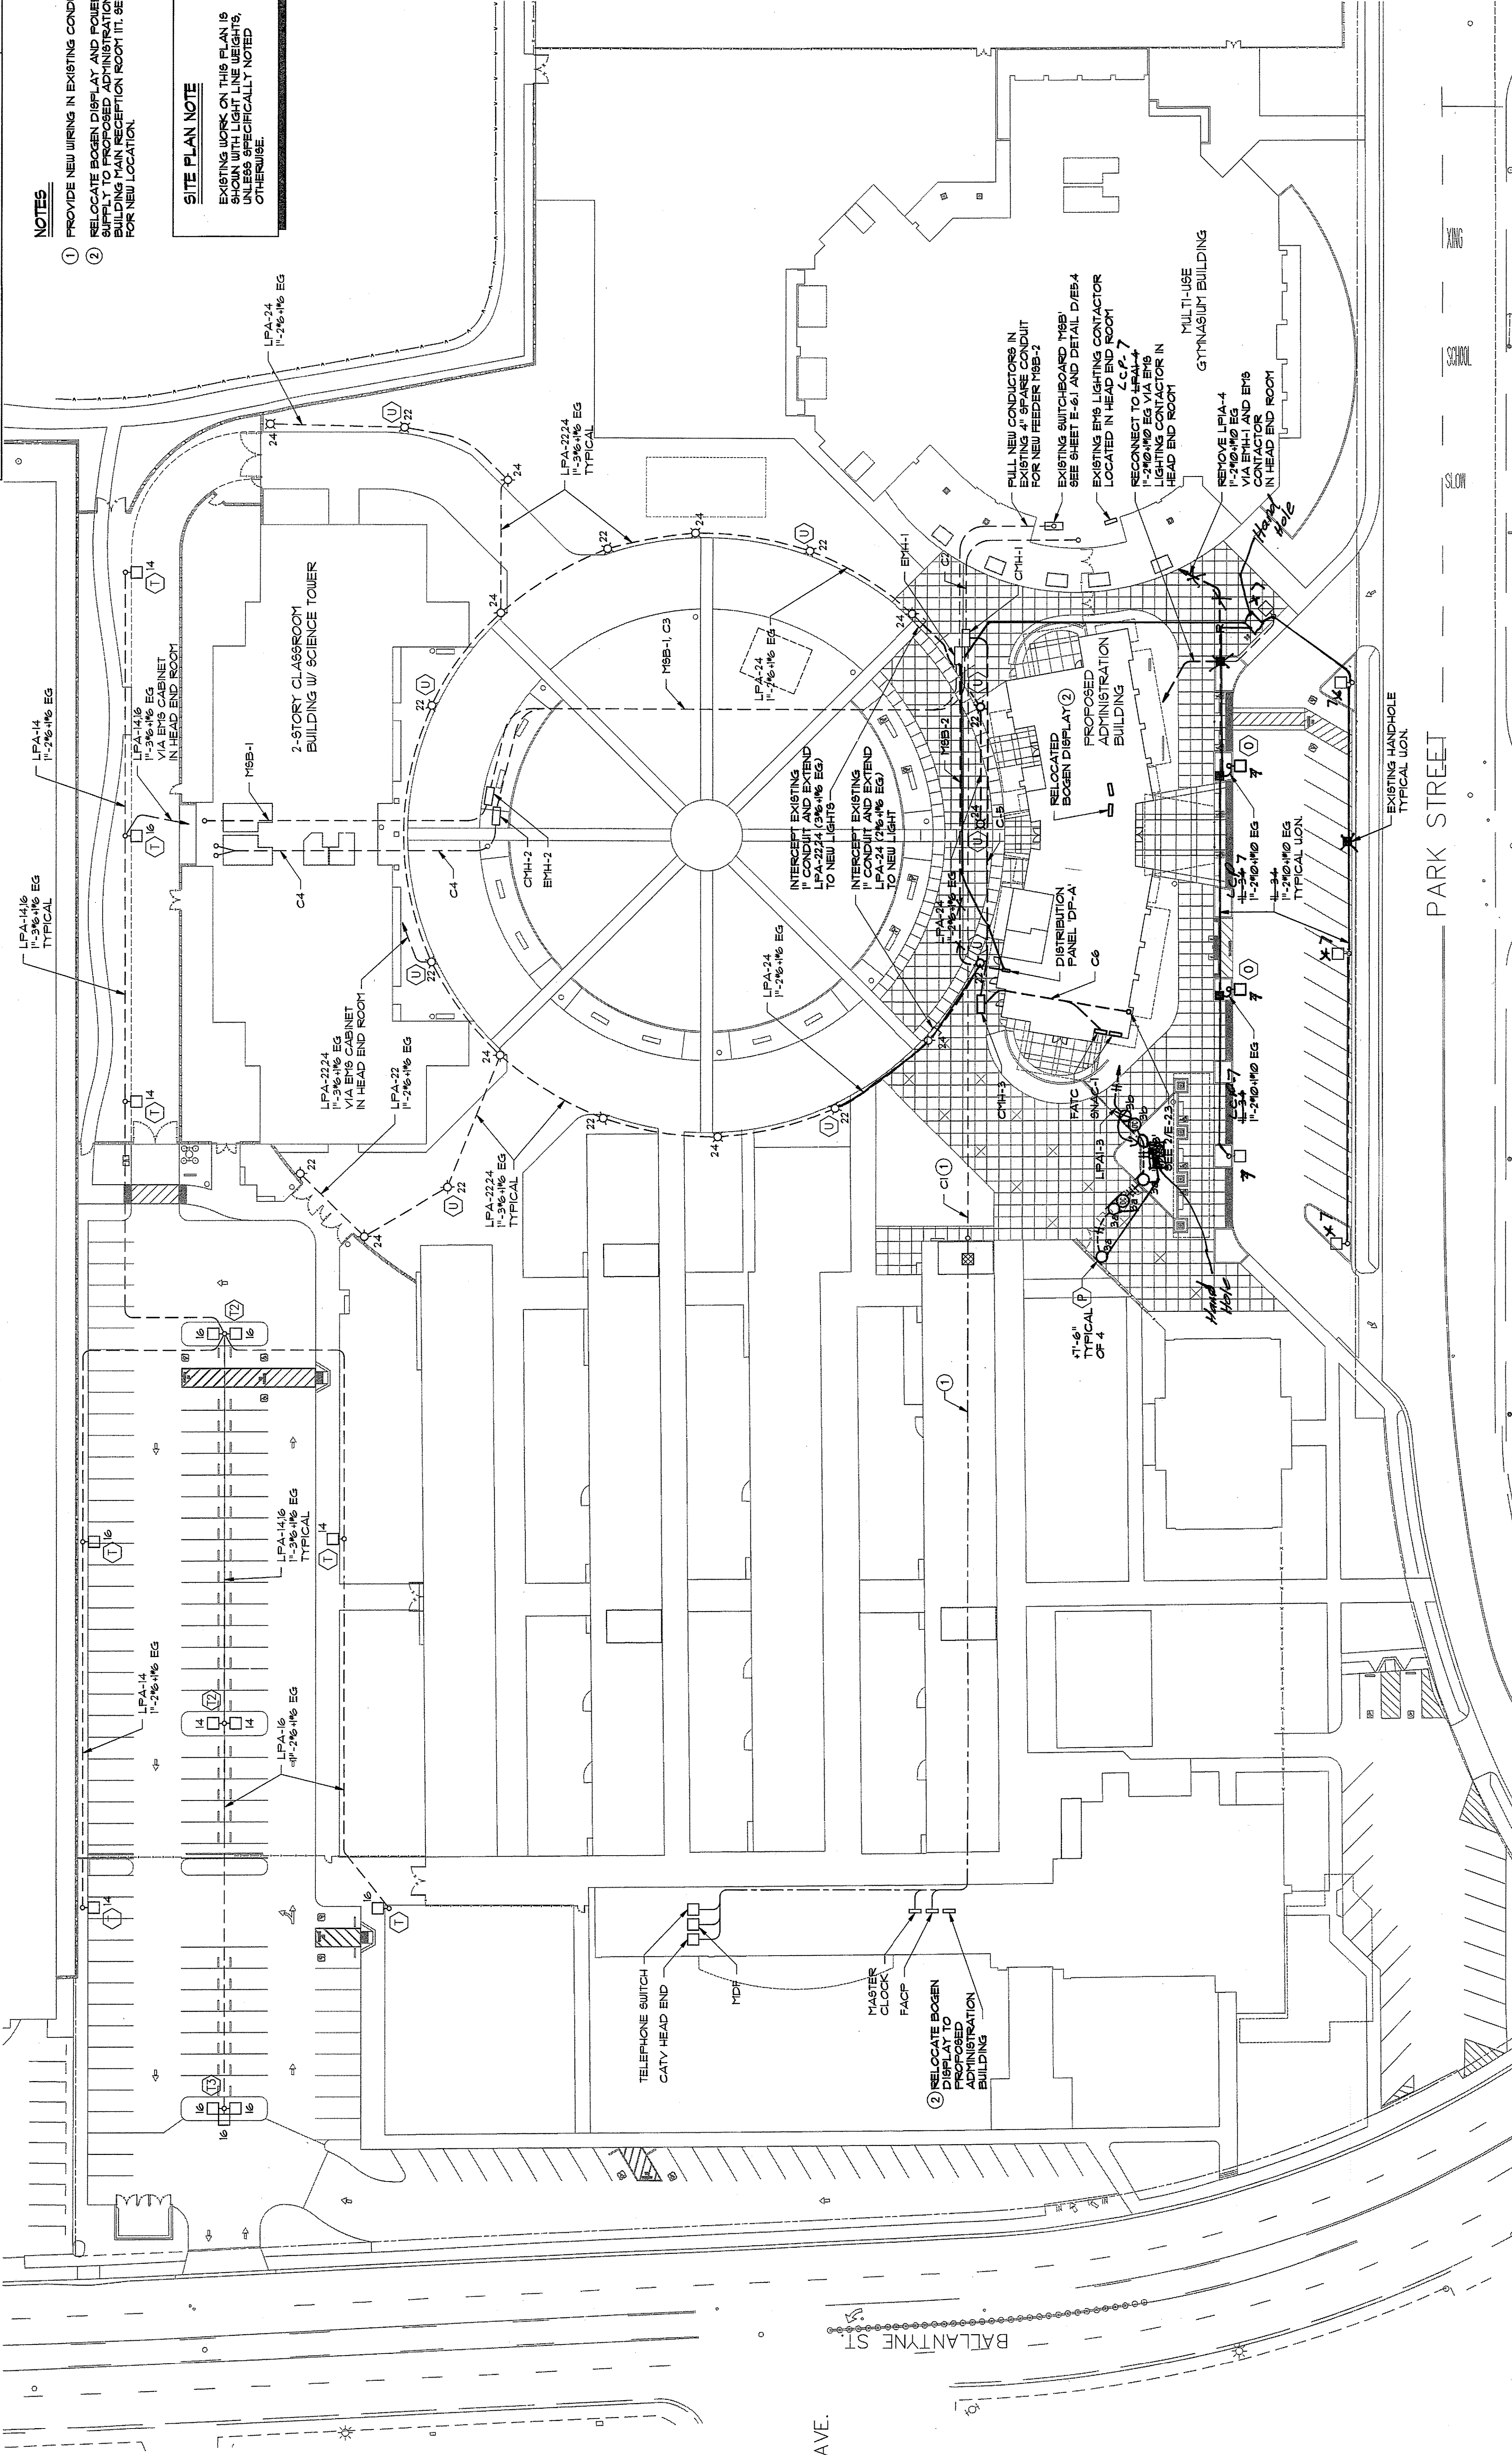

TRENCHING NOTE
LOCATIONS OF EXISTING UNDERGROUND UTILITY AND OTHER UNDERGROUND OBSTRUCTIONS AND CONDITIONS ARE GENERALLY UNKNOWN. HIRE A UTILITY LOCATING SERVICE TO LOCATE ALL EXISTING UNDERGROUND UTILITIES PRIOR TO DIGGING. VERIFY EXACT LOCATION, SIZE AND EXTENT OF ALL EXISTING UTILITIES PRIOR TO ANY TRENCHING. TAKE EVERY PRECAUTION TO PREVENT DAMAGE TO EXISTING WORK, INCLUDING HAND DIGGING AROUND EXISTING UTILITIES, PRIOR TO TRENCHING. TAKE EVERY PRECAUTION TO PREVENT DAMAGE TO EXISTING ROOT SYSTEMS AND LANDSCAPE FEATURES. ANY DAMAGE TO EXISTING ROOT SYSTEMS AND LANDSCAPE FEATURES SHALL BE REPAIRED OR REPLACED IN ACCORDANCE WITH THE OWNER'S DIRECTION AT THE CONTRACTOR'S EXPENSE.

SPECIAL INSTRUCTIONS
1. IN THE COURSE OF TRENCHING AND SAUCUTTING EXISTING WALKWAYS/PAVEMENT, REPLACE SOIL, SHRUBS, BUSHES, TREES, AC PAVING, PARKING LOT STRIPING AND REFILL/PATCH CONCRETE, ETC. TO MATCH EXISTING SURFACES.

COMMUNICATIONS DUCT BANK SCHEDULE

CONDUIT NAME	FROM	TO	TOTAL NUMBER OF CONDUITS	4"	6"	8"	12"
C1	ADMIN	CHH-1	3	1	6		
C2	CHH-1	DF-1	3	1	6		
C3	CHH-1	CHH-2	3	1	6		
C4	CHH-2	DF-2	3	1	6		
C5	CHH-2	CHH-3	3	1	6		
C6	CHH-3	DF-3	3	1	6		

CONDUIT BREAKDOWN


PIER CONDUITS 1/4" INTERCONDUCTS	FA	F1	F2	F3	F4	C1	C2	C3	SP	FA	6	C	B	TV	1	5
4"	-	-	-	-	-	4"	-	-	-	4"	2"	2"	2"	3"	2	2
4"	-	-	-	-	-	4"	-	-	-	4"	2"	2"	2"	3"	2	2
POWER FEEDER SCHEDULE

FEEDER NAME	FROM	TO	NUMBER OF CONDUITS	4"	6"	8"	12"	CONDUCTOR SIZE	RUN VIA
MSB-2	BUILD MSB	DPA	(1) 4"	-	-	-	-	(4/000 KCMIL EG)	EPH-1
-	-	-	-	-	-	-	-	-	-

POWER AND SIGNAL HANDHOLE SCHEDULE

NAME	SIZE	TYPE
CHH-1	4"x6"x4"	(EX)
EPH-1	3"x5"x4"	(EX)
CHH-3	4"x6"x4"	(EX)

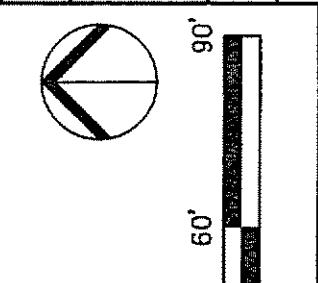


ELECTRICAL SITE PLAN


1"

MARK FORTIE, RCDD
REGISTERED COMMUNICATIONS DISTRIBUTION
BICS I
EXPIRES 12/31/08
Regla. No. 031432

① PROVIDE DAYLIGHTING CONTROLLER ABOVE CEILING. MAKE ALL 277 VOLT AND LOW VOLTAGE CONNECTIONS TO LIGHT SWITCHES, PHOTOCELL, BALLASTS AND CONTROL BOX. PROVIDE 3/4" AND WIRING LOOP BACK TO LIGHTING CONTROL PANEL 'LCP-DL'. SEE DETAIL J/E-5.6 FOR TYPICAL WIRING CONNECTIONS.

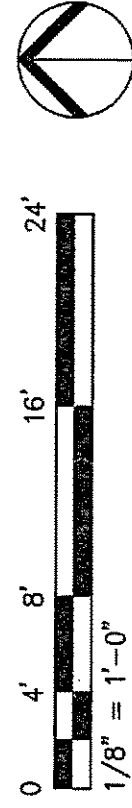

CONSULTANT	ARROW - MEADOWS CONSULTANTS
RECORD DRAWINGS	DATE: 1/16/08 BY: <i>[Signature]</i>
REVISIONS	
APPROVALS	CERTIFICATION STAMP DATE: 09/12/06 OFFICE OF REGULATION SERVICES 04 - 107941 AC. NO. F-8471 DATE: SEP 14 2006
DESCRIPTION	FLOORPLAN LIVING
DATE	09/12/06
JOB #	05365.00
	0212_6
SHEET #	
E-2.1	

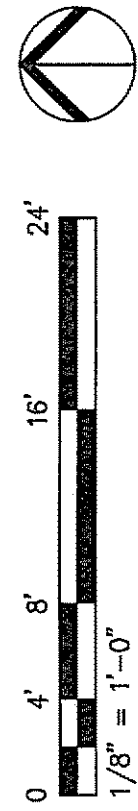

09/06/06



1. SEE GENERAL NOTE #1 ON SHEET E-0.1 FOR DIMENSIONS OF UNDERGROUND CONDUIT SWEEPS.



1. SEE SITE PLAN FOR EXACT NUMBER OF CONDUITS, DUCTS AND ROUTING.
2. P = POWER CONDUIT, C = COMMUNICATION CONDUIT

DUCT BANK STUB-UP INTO BUILDING AT IDF

NO SCALE


B

E-54



- NOTE**
- ① EXISTING SWITCHBOARD #45B1 PREVIOUSLY DSA CERTIFIED UNDER #04-105954. SEE SHEET E-11 FOR LOCATION
- ② PROVIDE 400VAT/400AF CB TO MATCH EXISTING AIC RATING AND ALL EXISTING HARDWARE.





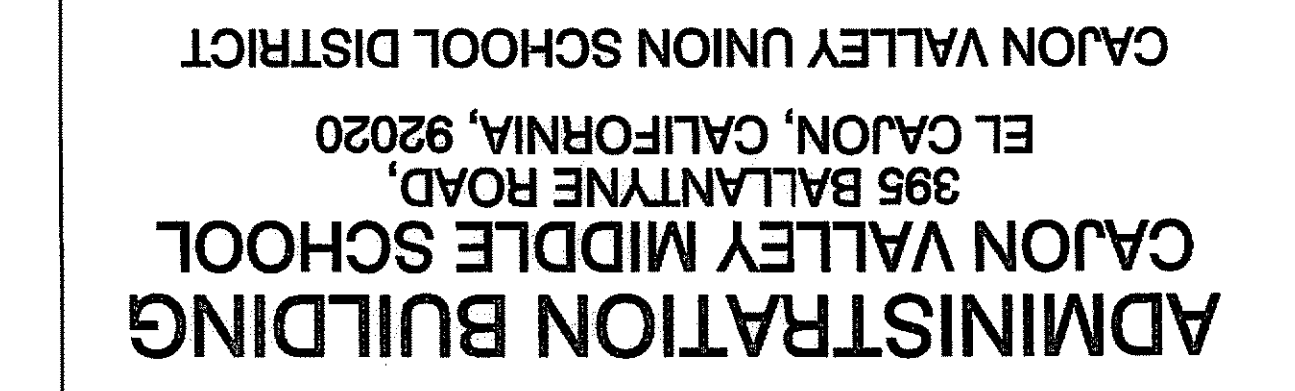

CONSULTANT	JOHNS CORP. FARMINGS <i>J. Johns</i>
REVISIONS	
APPROVALS	PORTER GROUP DIV. OF THE STATE ARCHITECT OFFICE OF REGULATION SERVICES 04 - 107941 <i>W. Porter</i> AG. — FILED IN SEP 14, 2006
DESCRIPTION	
DETAILS	
DATE	09/12/06
JOB #	05365.000
SHEET #	0712_6
E-6.5	













- ① FIRE - RATED WALL PER ARCHITECTURAL.
- ② CONDUIT PER PLANS
- ③ FILL VOID CAVITY WITH FIRE RESISTIVE MATERIAL. THE MATERIAL USED SHALL BE EQUAL TO THE RATED WALL. ALL OTHER EQUAL PENETRATIONS SHALL BE PROTECTED BY MATERIAL AND INSTALLATION DETAILS THAT CONFORM TO U.L. LISTING "UL-1020" FOR THROUGH PENETRATION FIRE STOP SYSTEM.

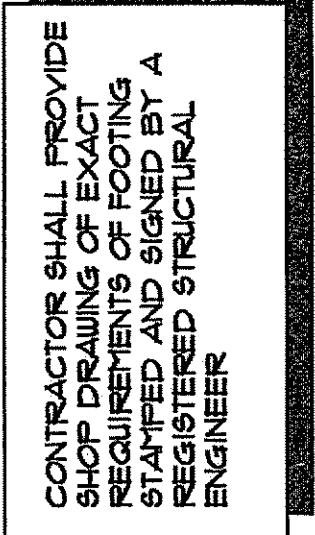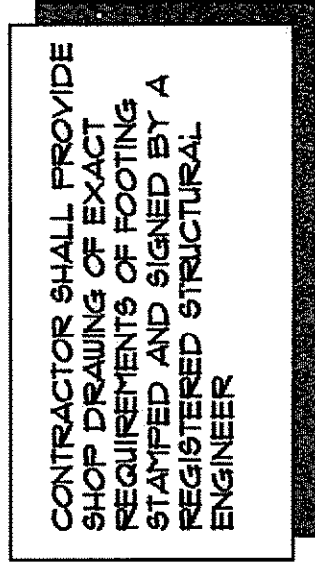

- ## NOTES

- ① POLE - 19 FOOT NOMINAL HEIGHT, STEEL POLE PER RECOMMENDED SCHEDULE.
- ② POLE BUILT BASE OF STEEL PLATE, PER MANUFACTURER'S RECOMMENDATIONS.
- ③ POURED IN PLACE ROUND CONCRETE SUPPORT BASE (1800 PSI) WITH TOP COATS OF NON-SACRIFICIAL GROUT WITH COATING ON ALL EXPOSED CONCRETE SURFACES.
- ④ REINFORCED BARREL, FABRICATED FROM RE-BAR(4) #5 VERTICAL AND 5 TIES AT 12" O.C.
- ⑤ ANCHOR BOLTS, USE MINIMUM (4) 3/4"x24" LONG ANCHOR BOLTS, SUPPLIED BY POLE/UTILITY MANUFACTURER.
- ⑥ CONCRETE WALKWAY AS SPECIFIED ON LANDSCAPE PLANS.
- ⑦ FOLLOWING INSTALLATION AND LEVELING OF POLE/UTILITY MANUFACTURER'S GROUT IN ALL AROUND CONCRETE BOTTOM OF POLE BASE AND TOP OF CONCRETE BASE.
- ⑧ 8/16 SERVICE CONDUIT UP INTO POLE BASE WIRING CAVITY AND DASH.
- ⑨ PROVIDE SUPPORT AND LEVELING NUTS AT TOP AND BOTTOM OF POLE BASE PLATE, TOP NUTS PER ANCHOR BOLT, BOLT SPACING PER HANGING PLATE.
- ⑩ TYPICAL 2" PVC SUEEP - 2"x10"x6 EG.
- ⑪ TYPICAL INCOMING EXTERIOR BRANCH CIRCUIT, SIZED PER PLANS.
- ⑫ TOP OF FINISH GRADE.
- ⑬ TYPICAL GRADE MOUNTED JUNCTION BOX, SEE DETAIL G/E-55.
- ⑭ 48 TIES AT 3' O.C. STARTING 2' FROM TOP OF BASE STRUCTURE
- ⑮ IN LINE WATER TIGHT FUSE HOLDER WITH FUSE, 8/16 FUSE IN LINE WITH 8/16 WIRING RECOMMENDATIONS, LOCATE AT POLE HANDHOLE.

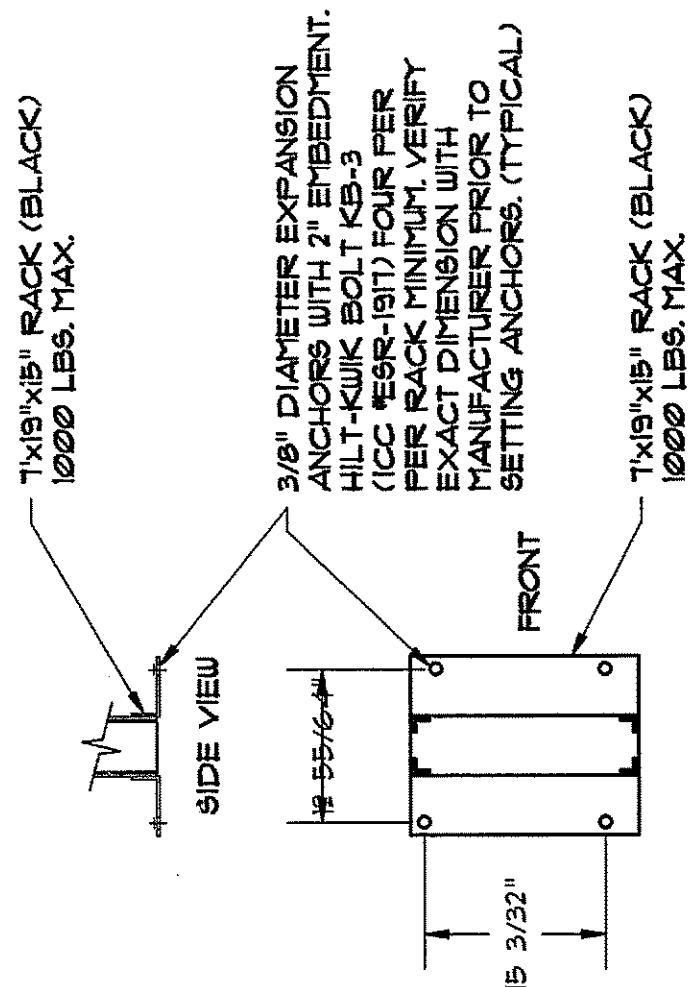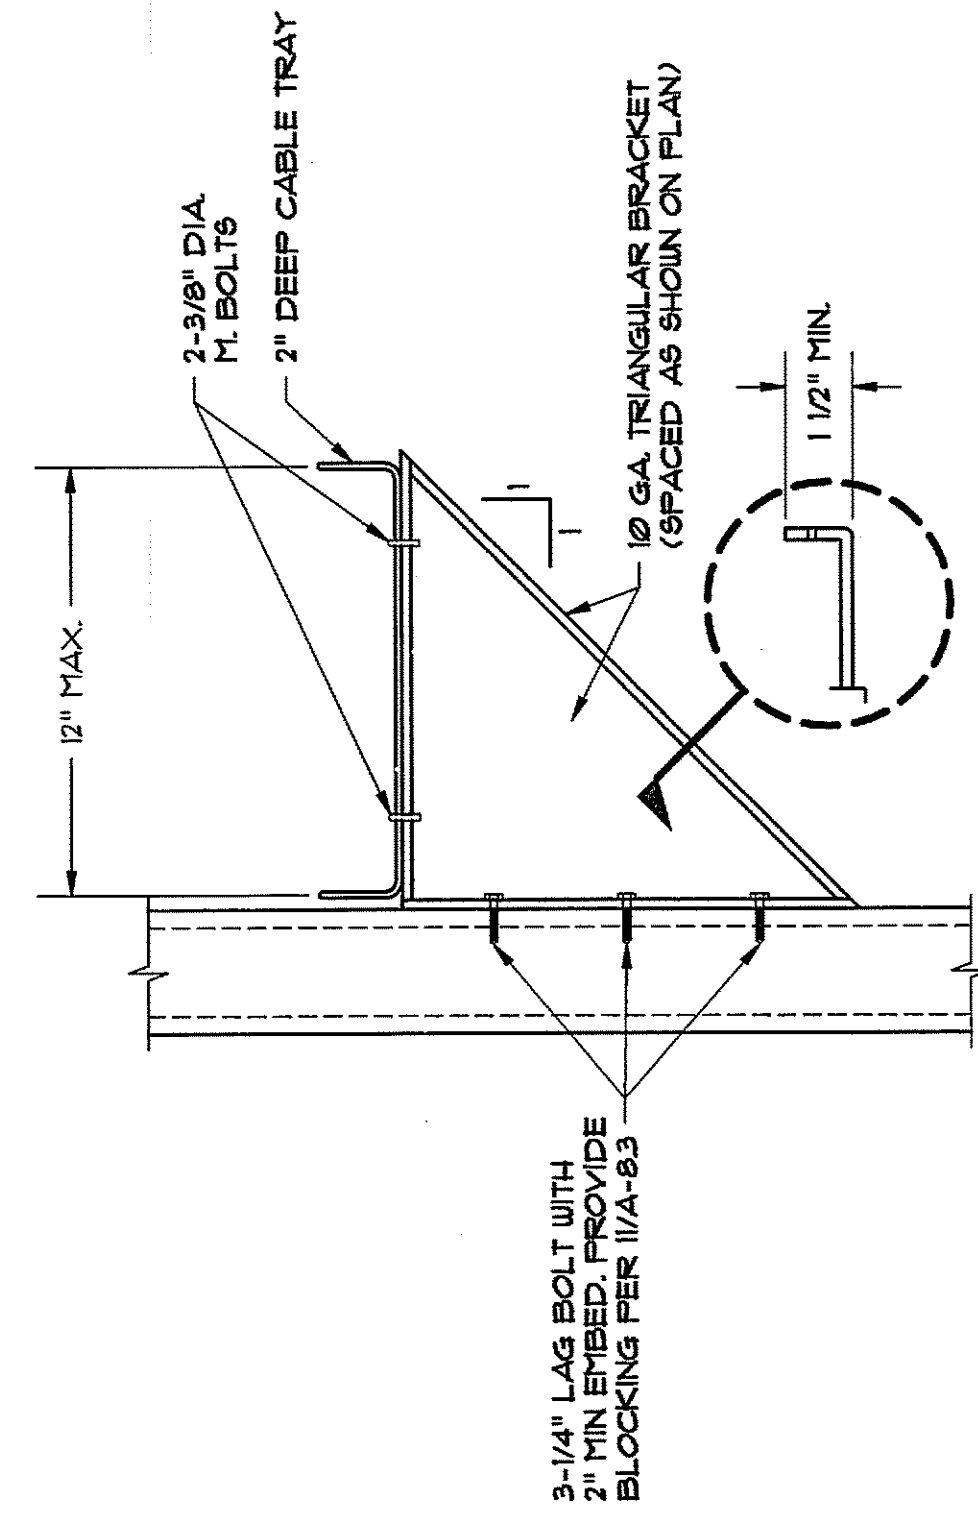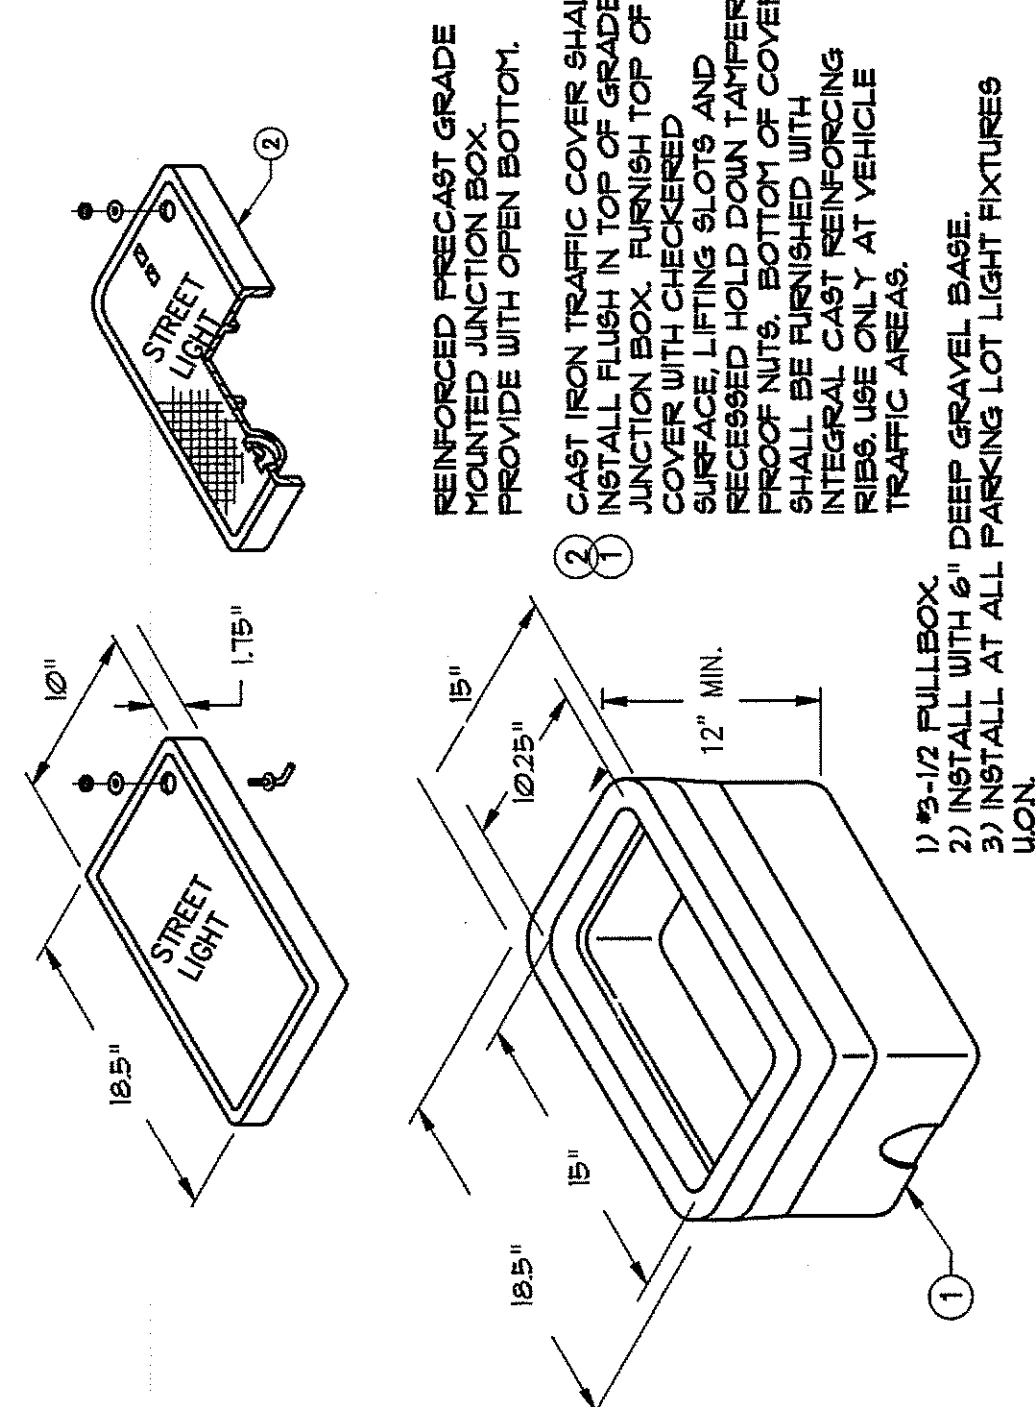

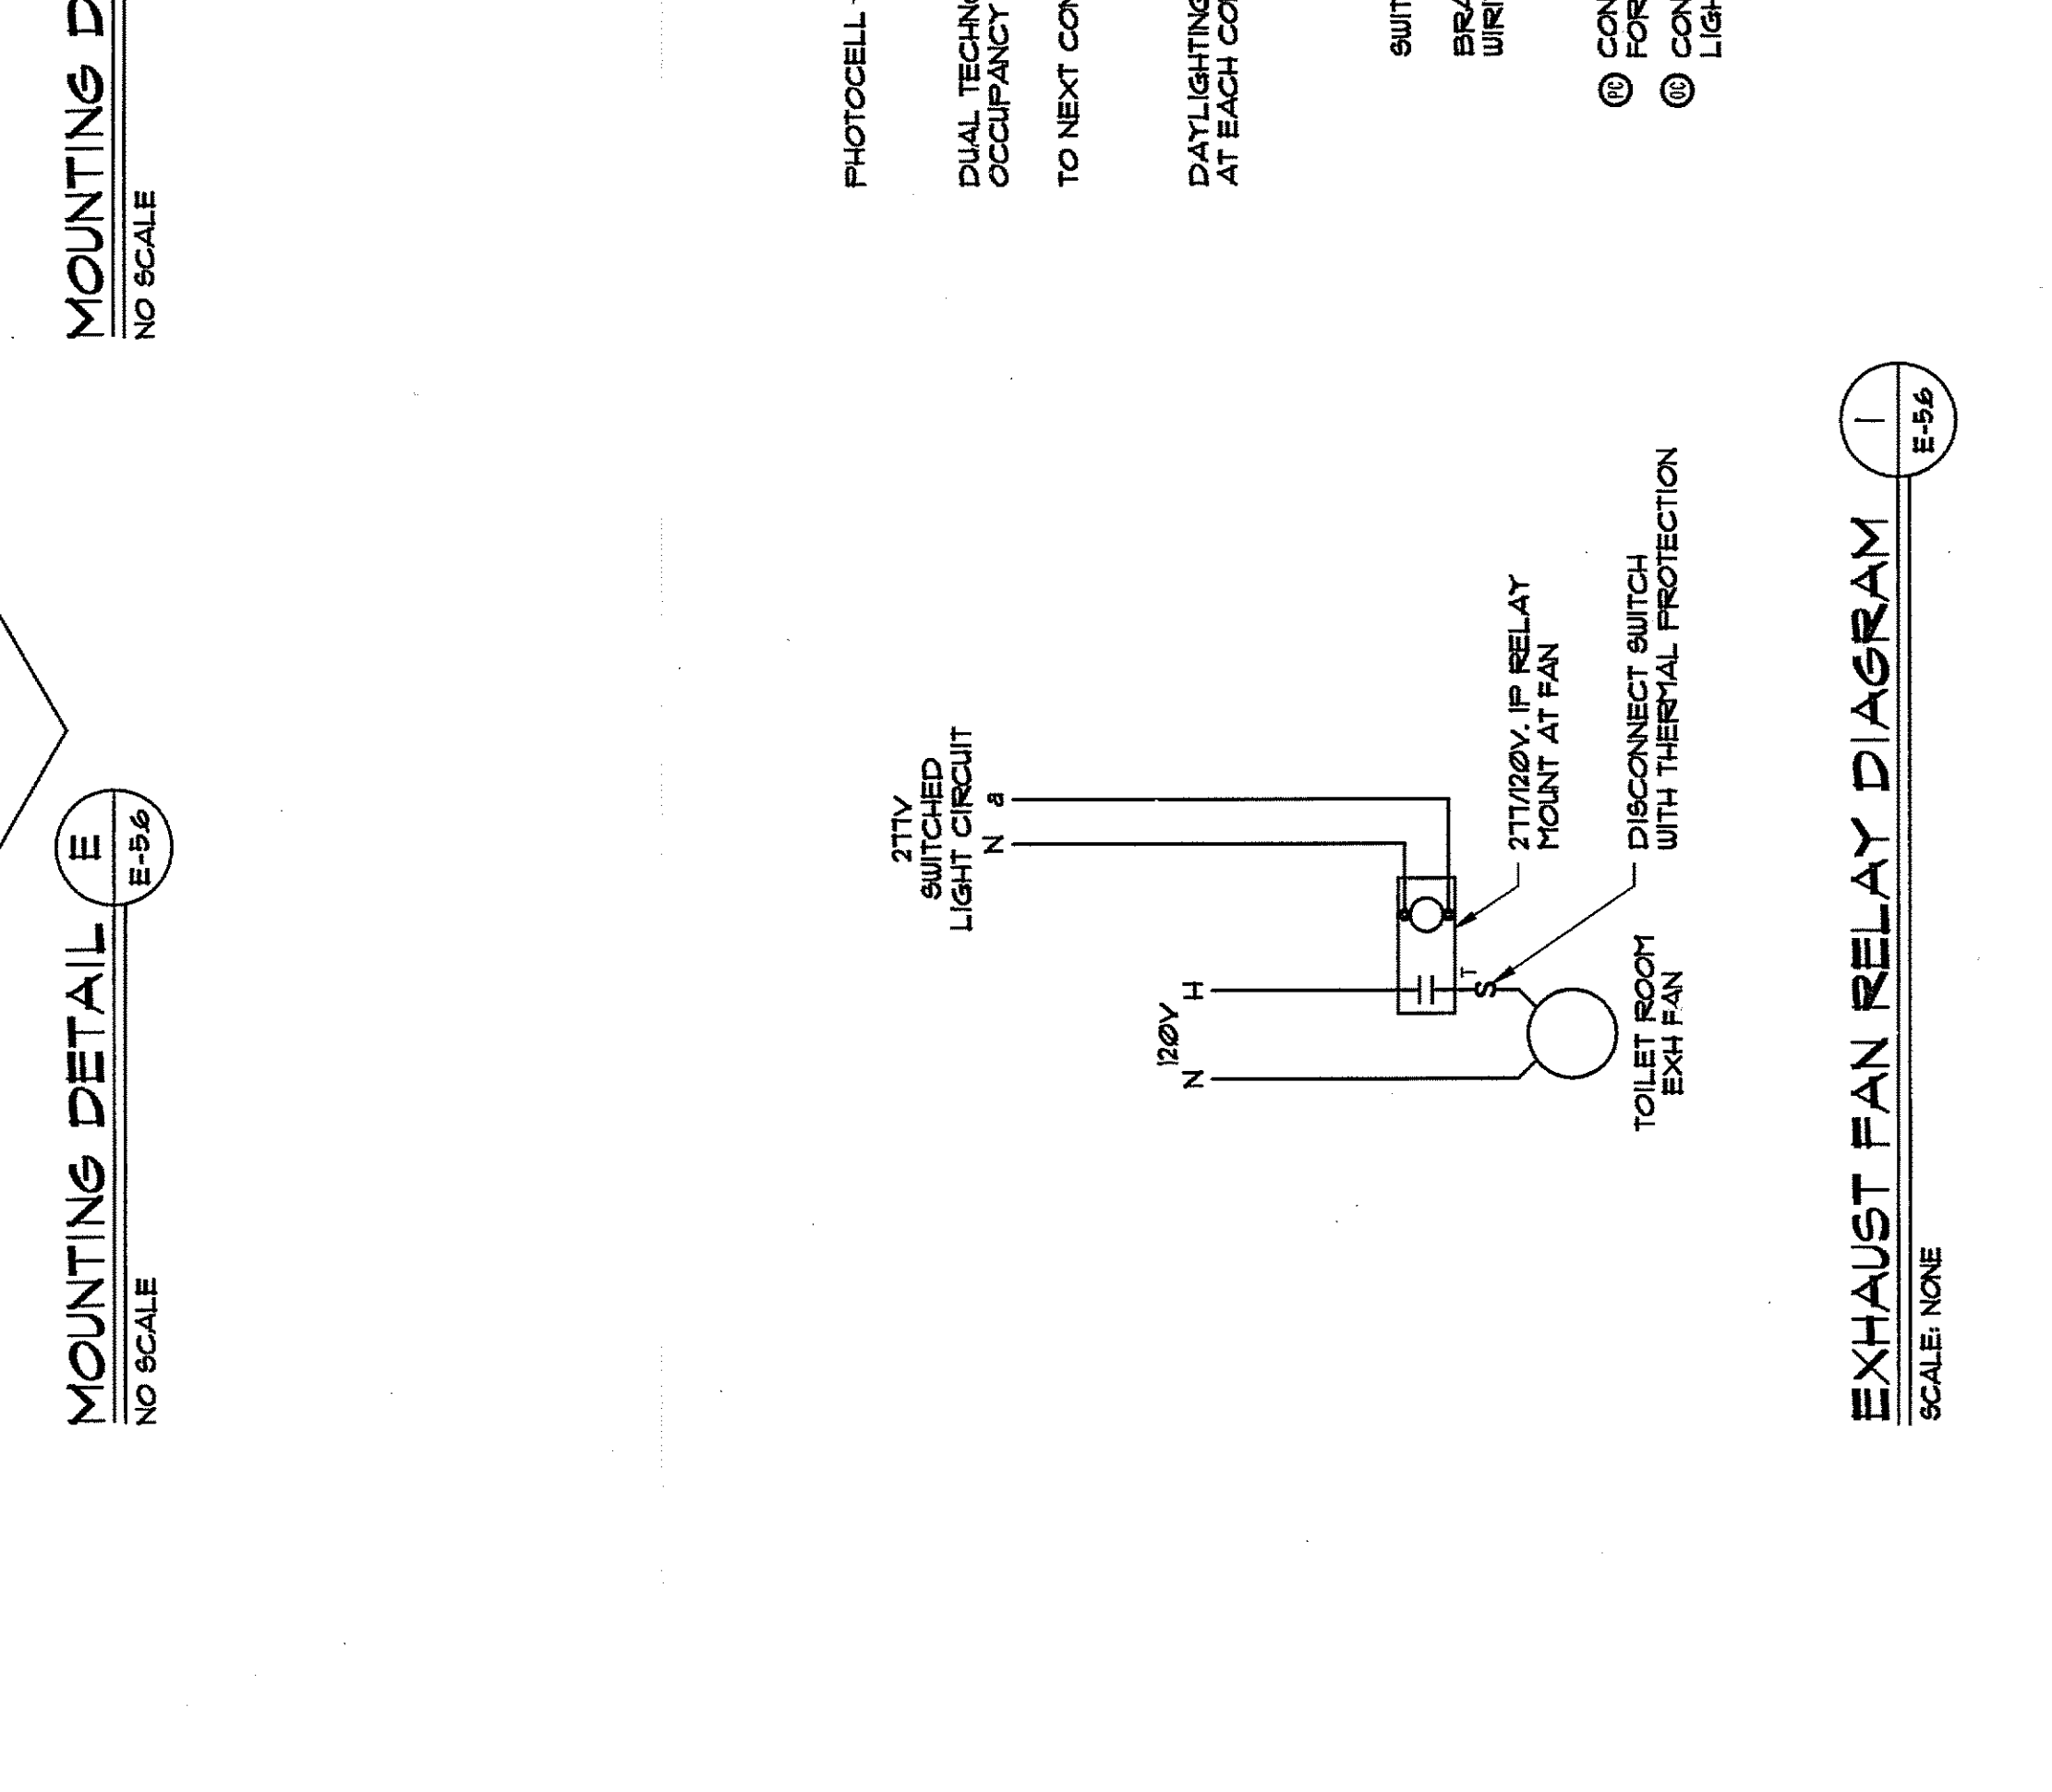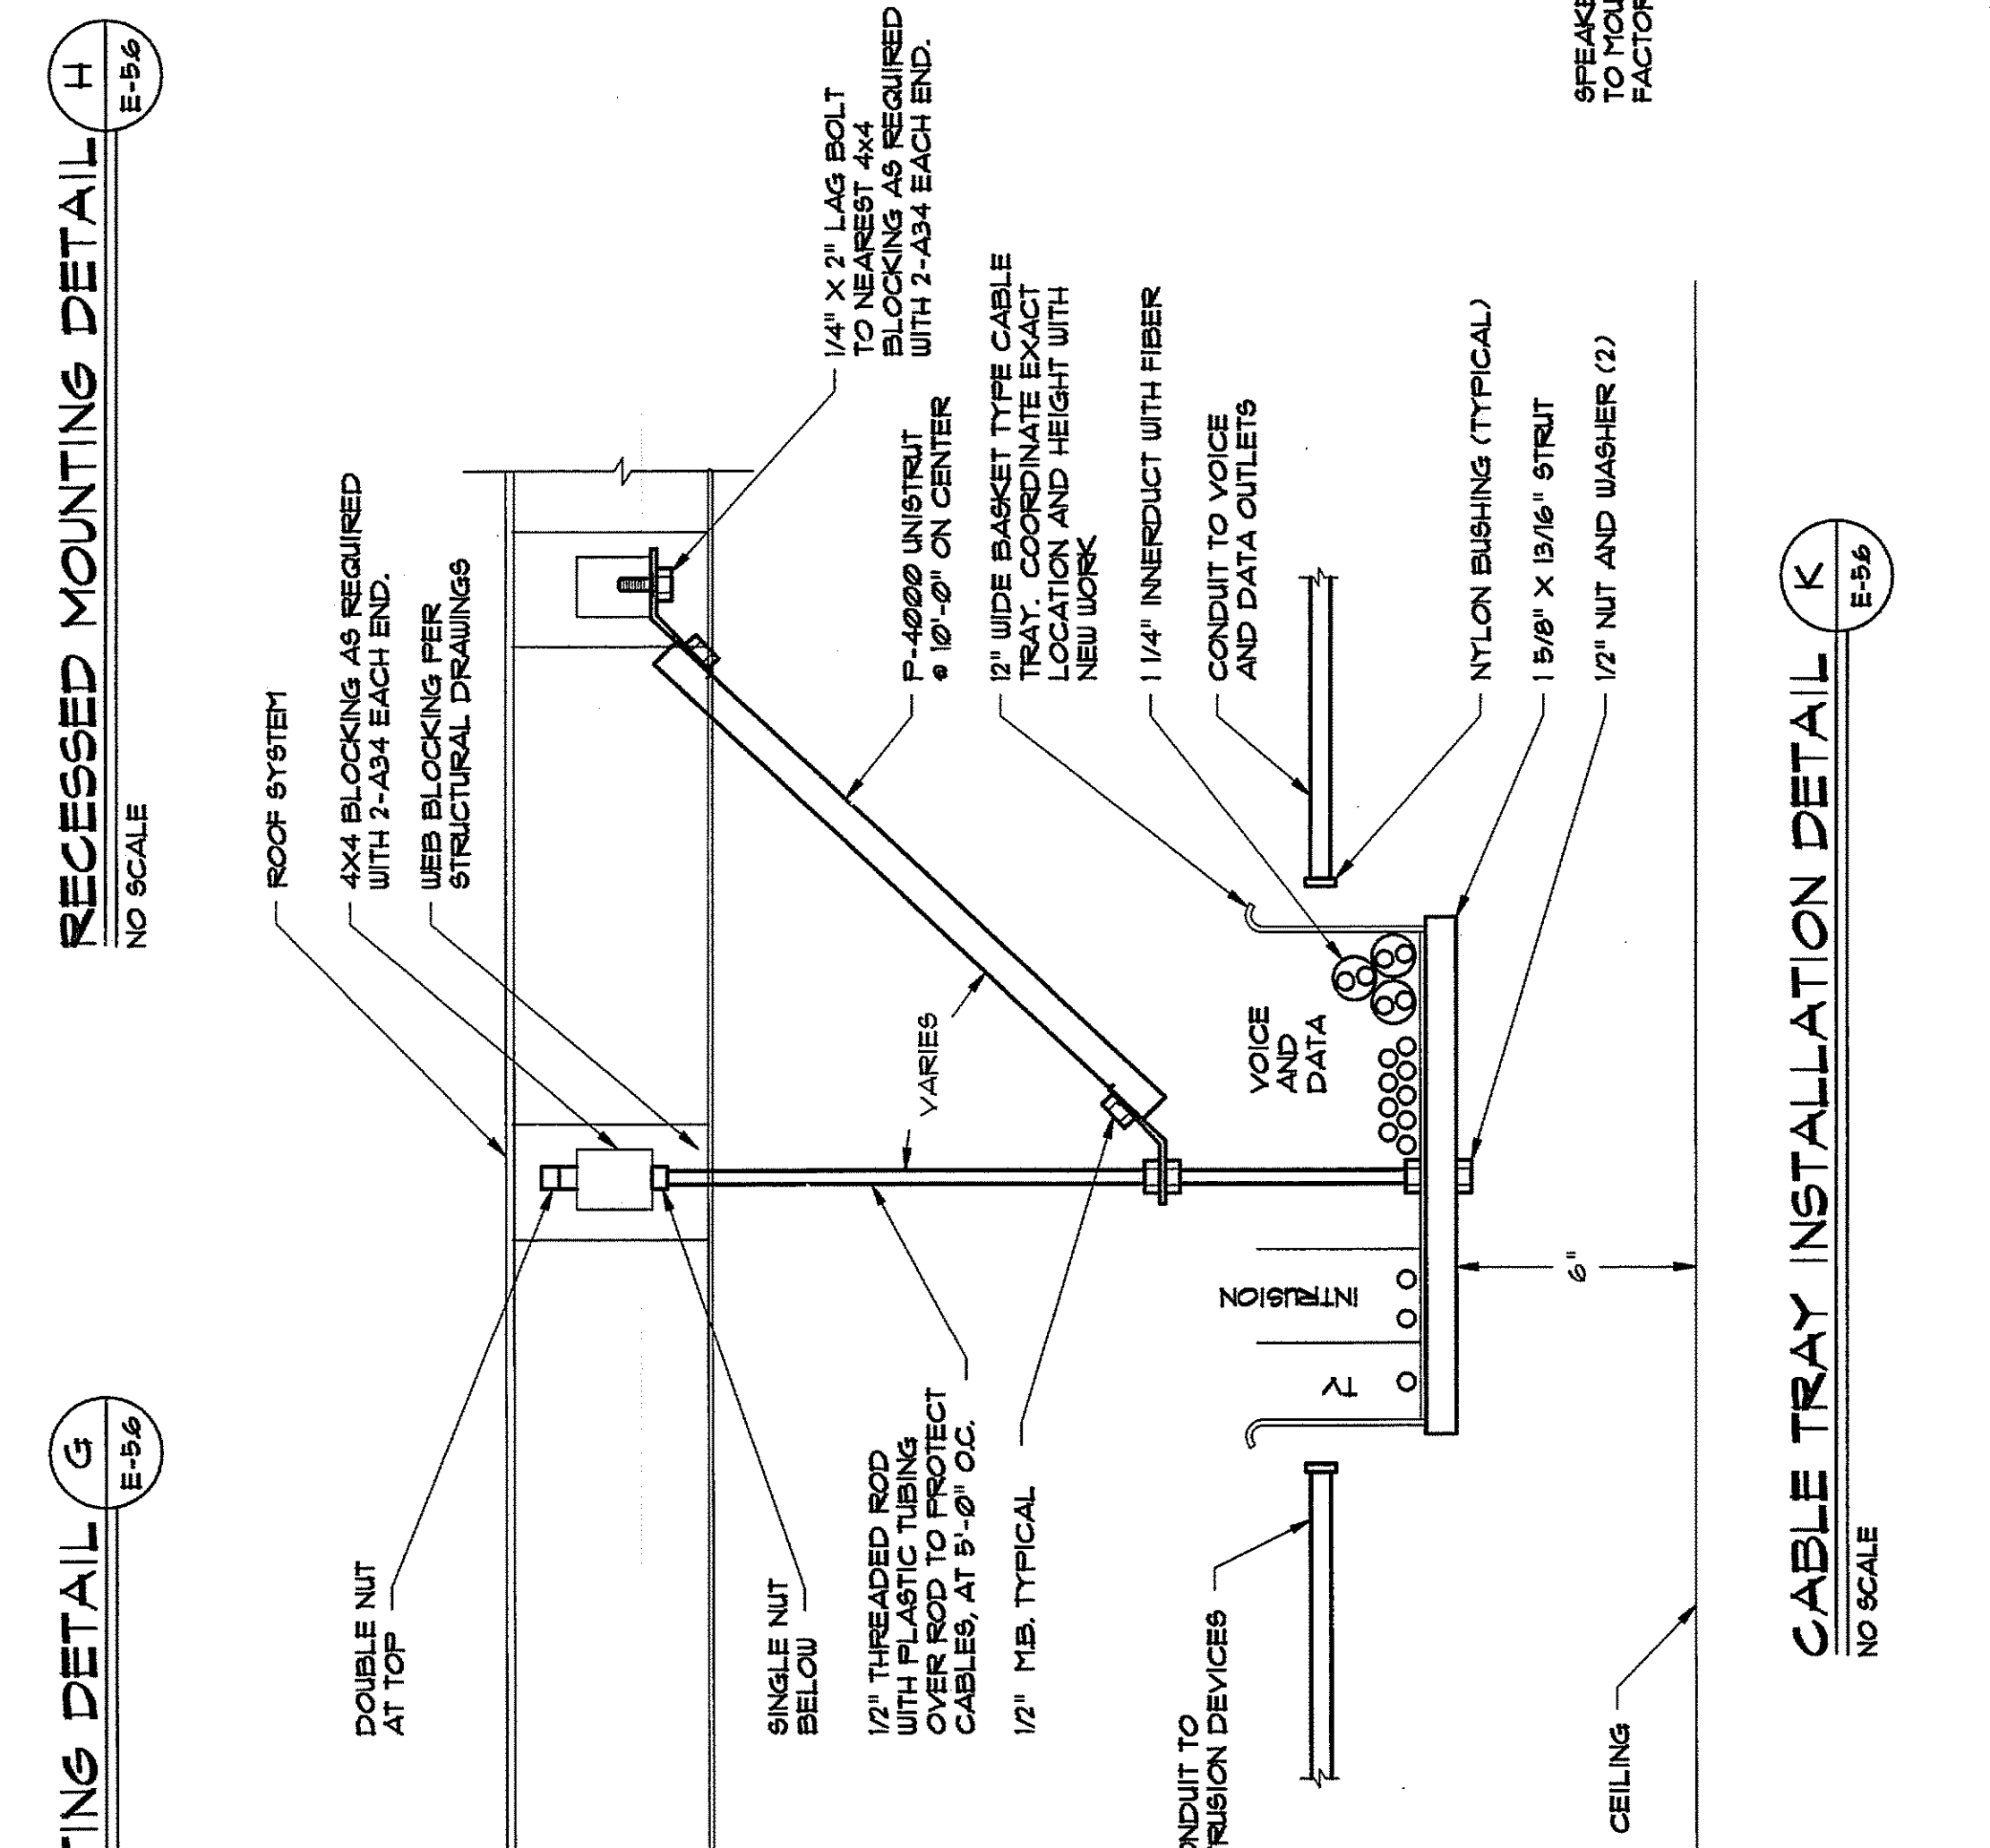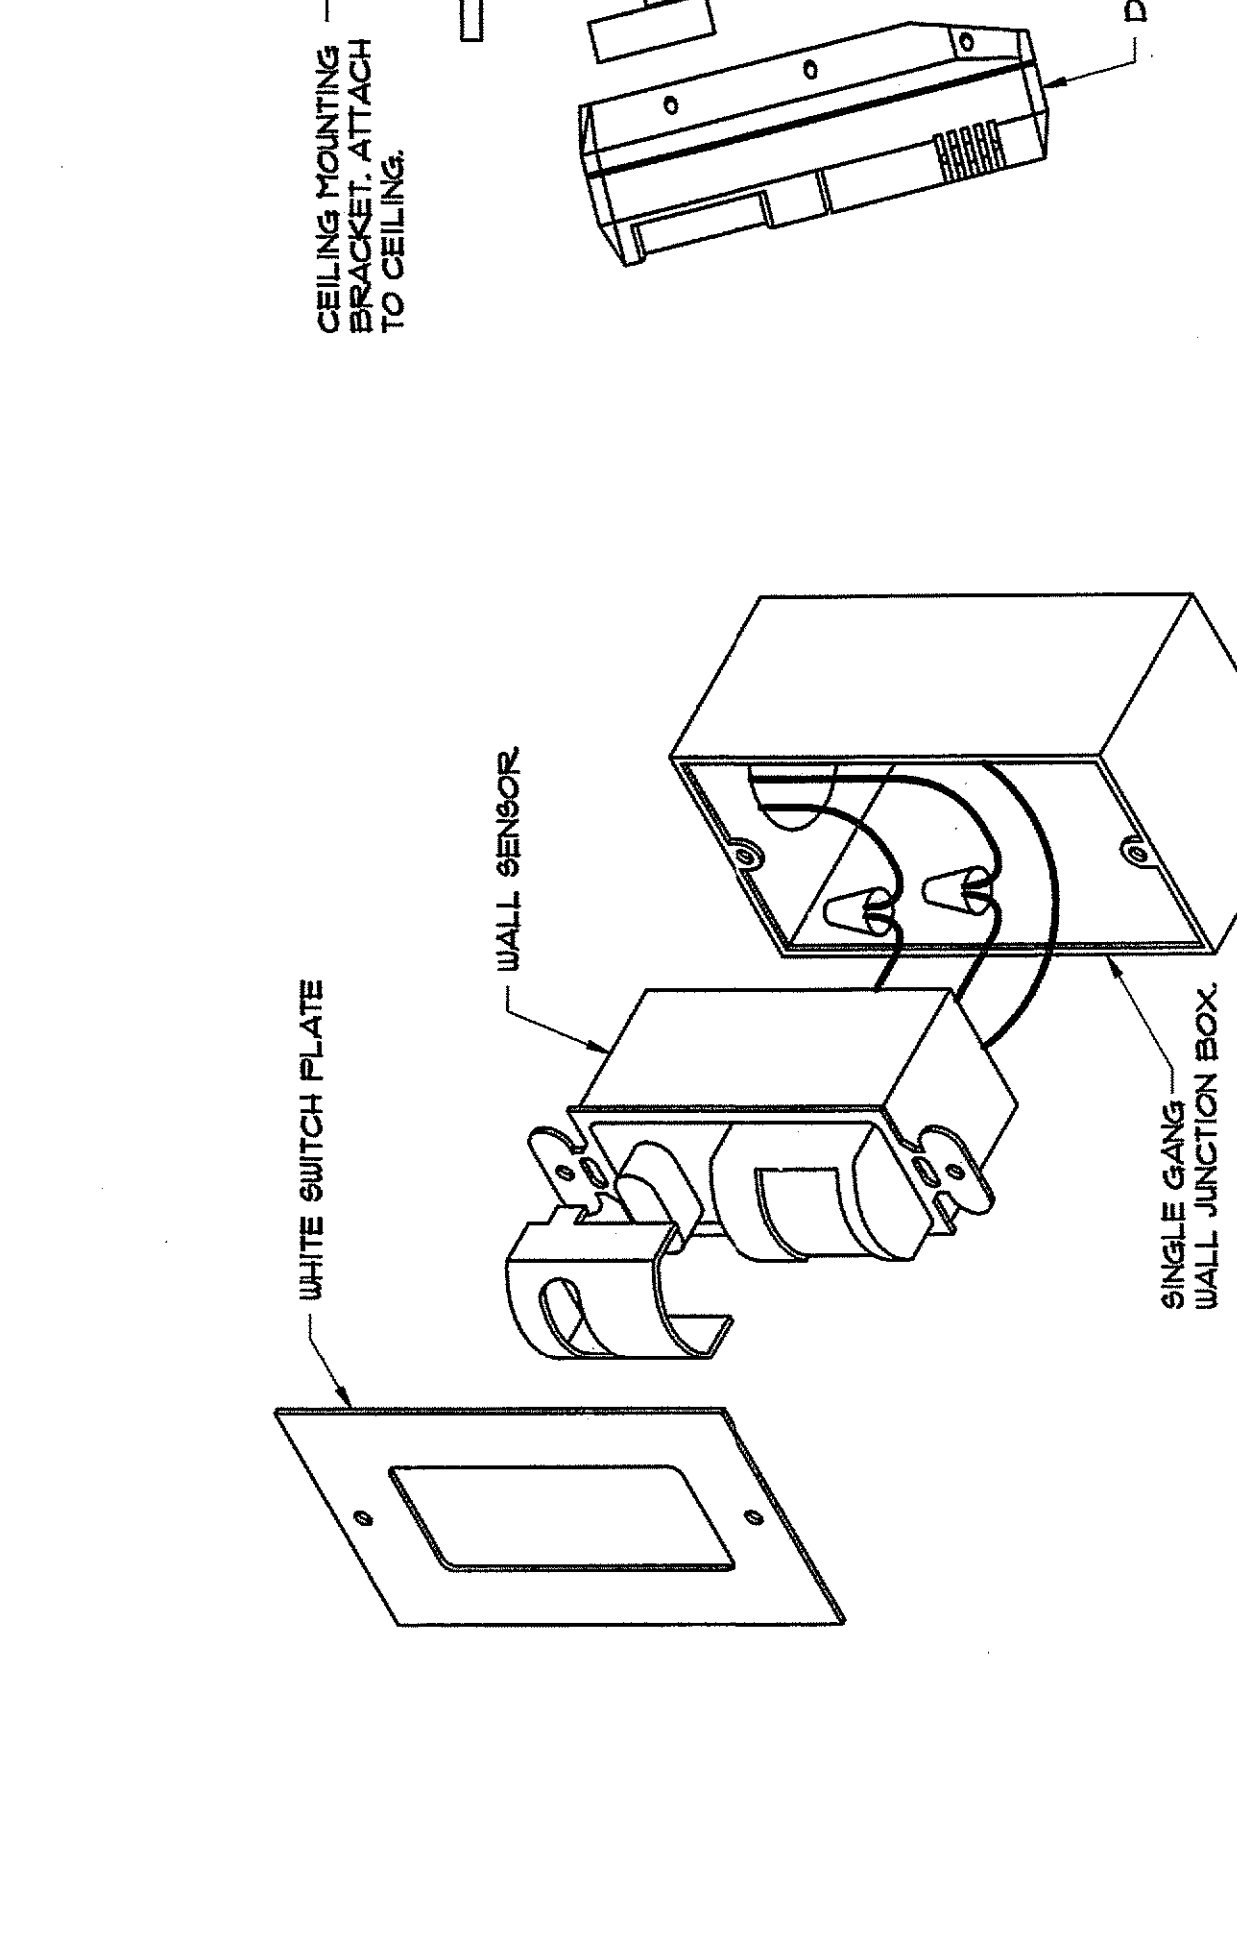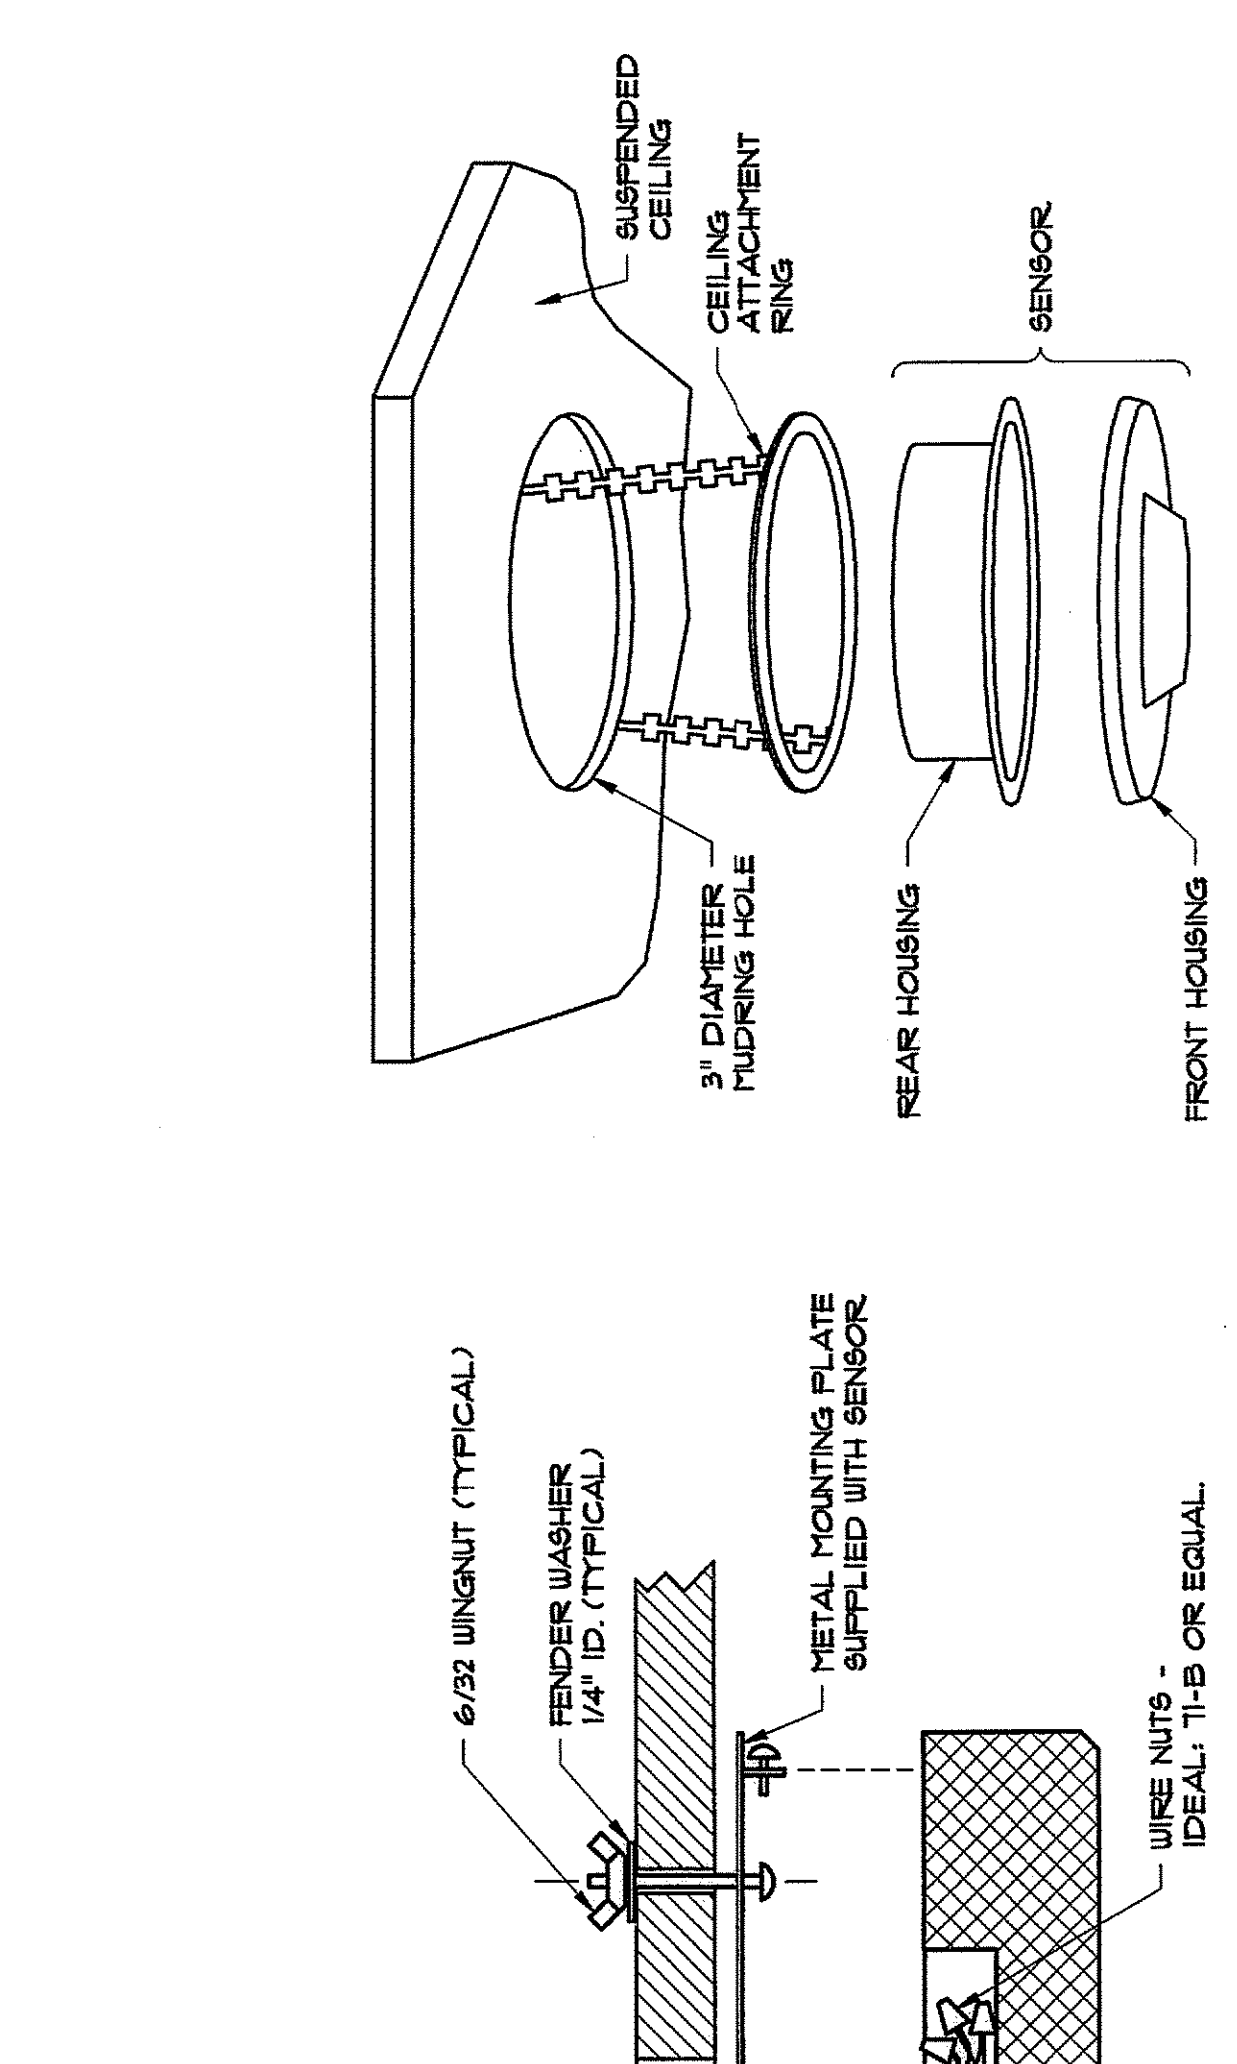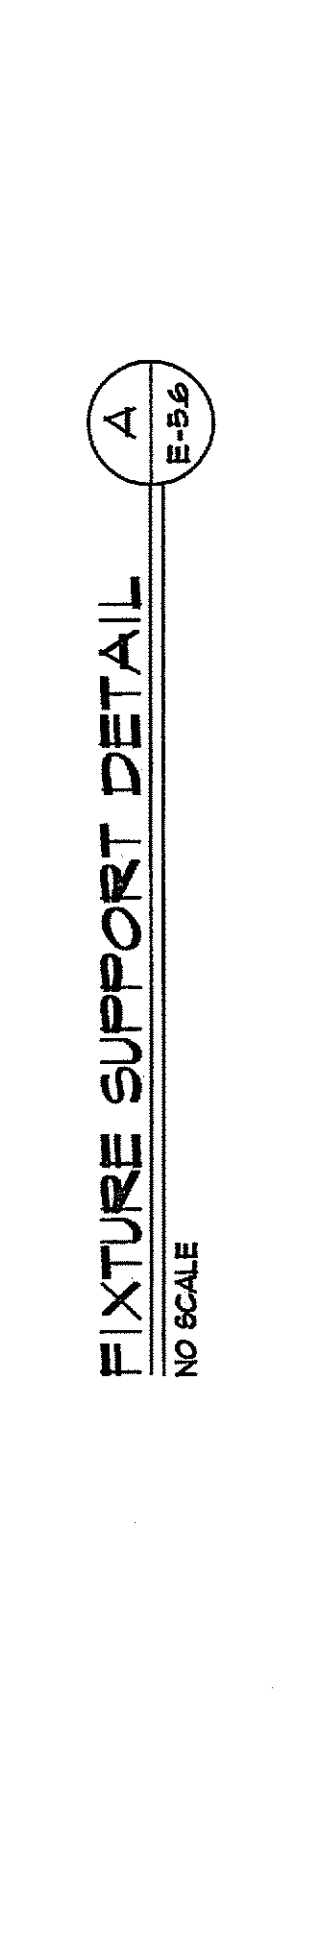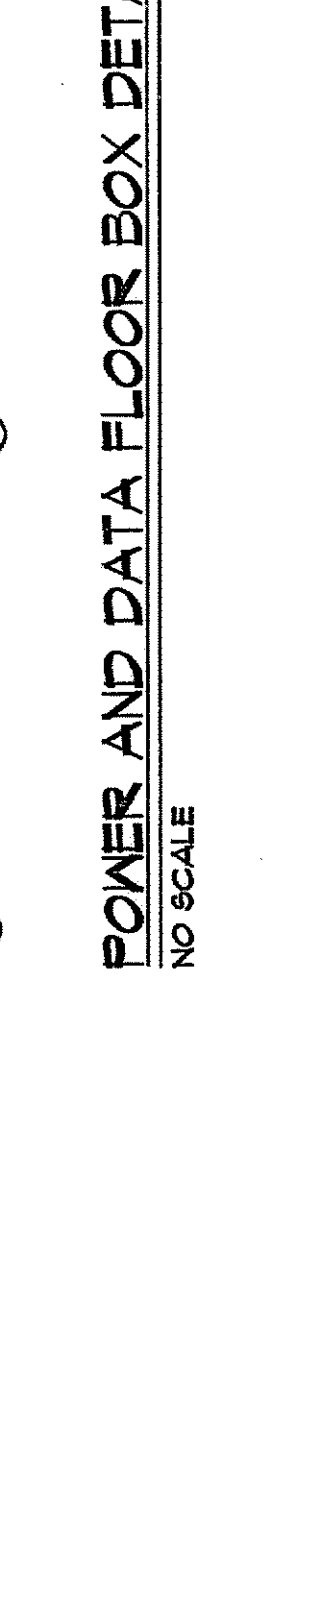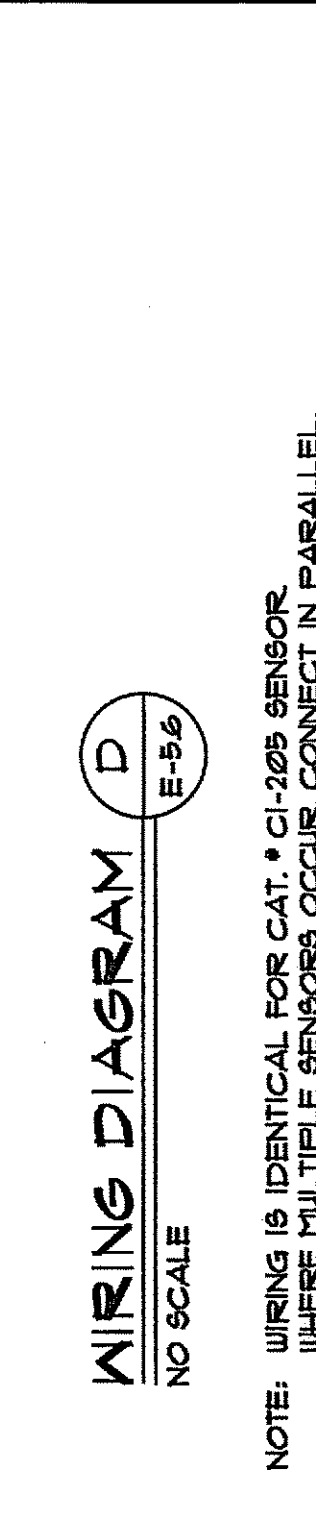


MARK FORTIE, RCDD

 BICSI
REGISTERED COMMUNICATIONS DESIGNERS

EXPIRES 12/31/08
Regis. No. 081432

- ① DO NOT BOND NEUTRAL TO GROUND.
- ② PROVIDE CIRCUIT BREAKER IN EXISTING "SPACE ONLY".
- ③ PROVIDE ARC FLASH WARNING PER DETAIL F/E-52.

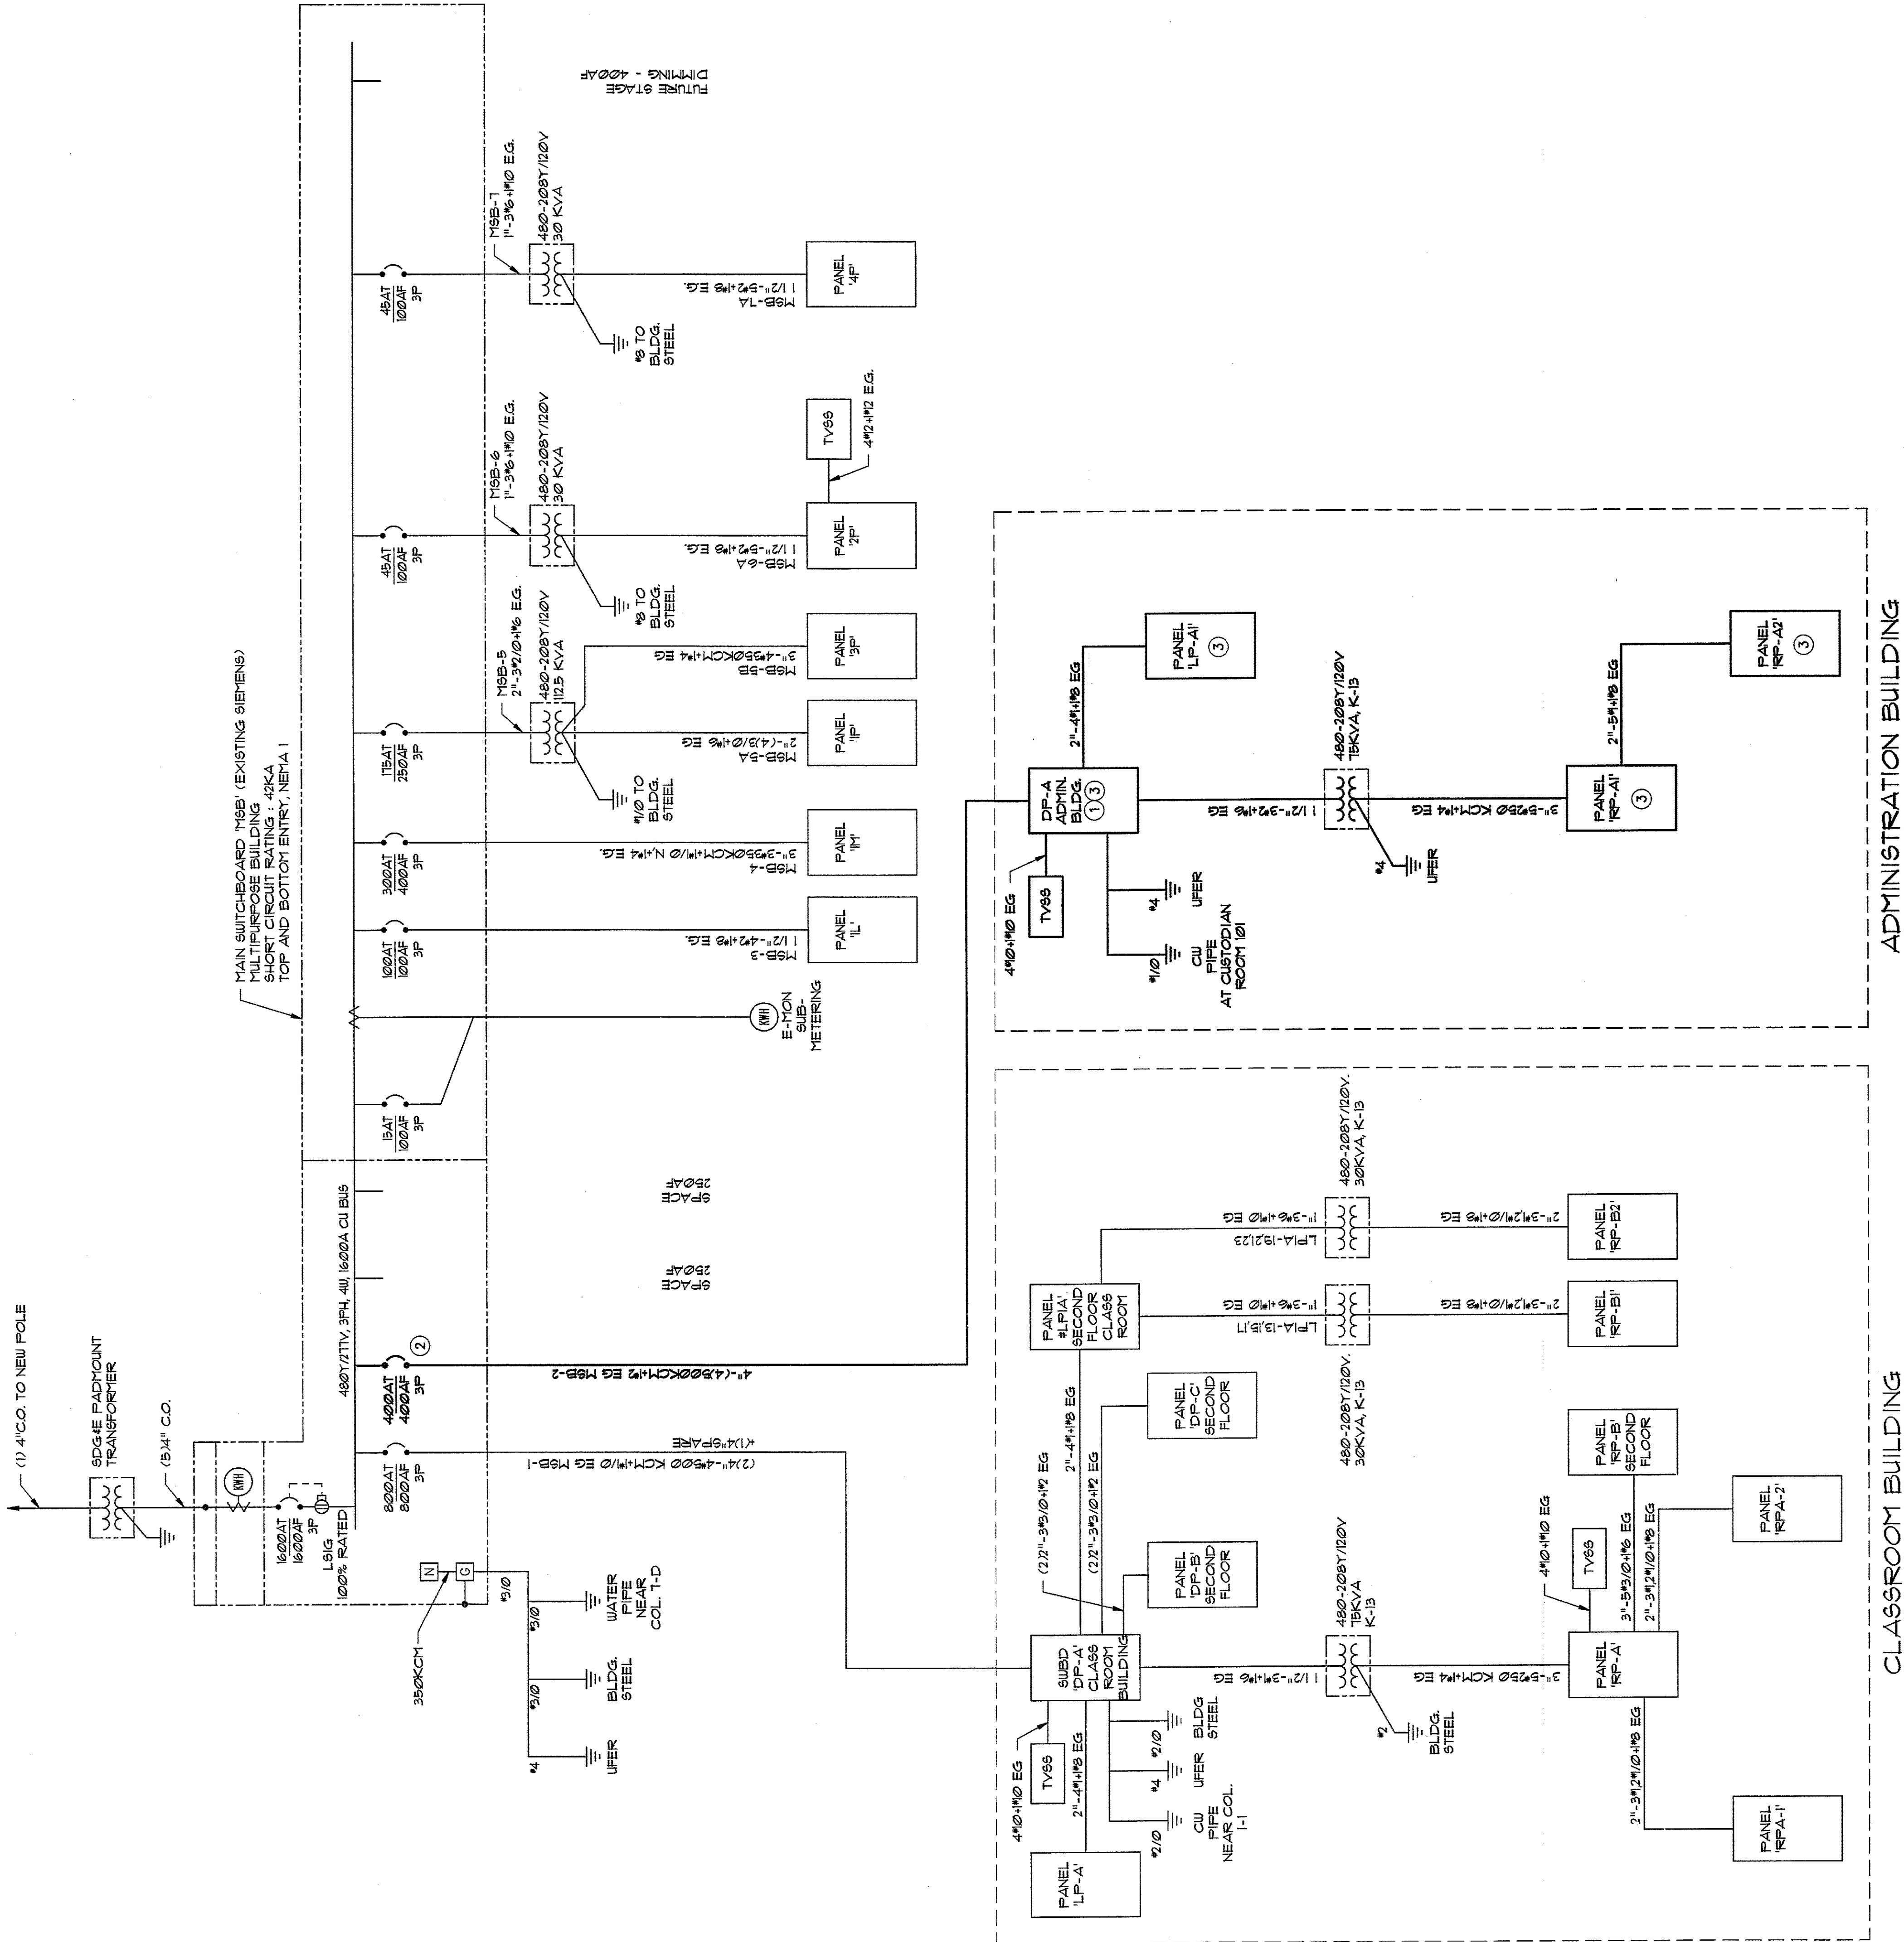



LOAD CALCULATIONS

EXISTING #8B
EXISTING #8B @25%
NEW ADMIN BUILDING DP-A
INCLUDES PANEL LP-A1


649 KVA
161 KVA
118 KVA
TOTAL 1044 KVA

CONCLUSION:
EXISTING 1600 AMP 3 POLE MAIN BREAKER IS SUFFICIENT.
1044 KVA @717/480V 3 PHASE 4WIRE = 256 AMP@

CONSULTANT	DOUGLAS CORP. DRAWINGS
REVISIONS	 04 - 107941 10 - 107941 11 - 107941 12 - 107941 265 - 1

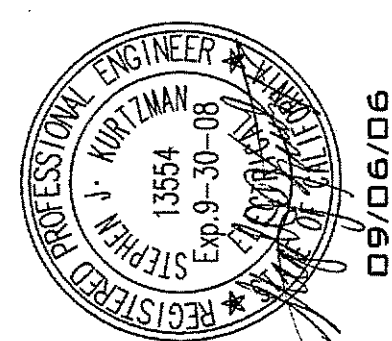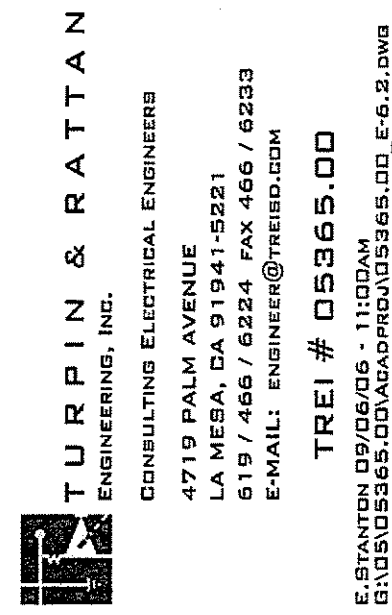

90/90/60

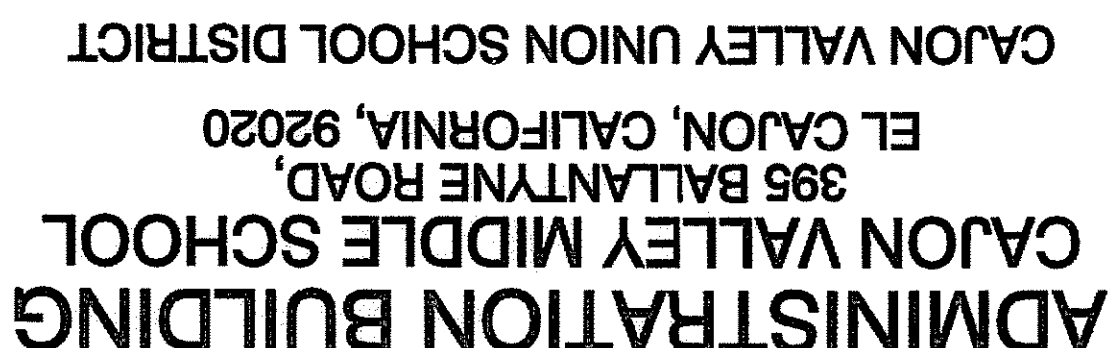

CONSULTANT

MORROW - MEADOWS CORP
RECORD DRAWINGS
DATE: 1/16/08
SIGN: [Signature]

REVISIONS

APPROVALS
IDENTIFICATION STAMP
V. OF THE STATE ARCHITECT
OFFICE OF REGULATION SERVICES

04 - 107941
AC. - FLS. 19 ss. *sup*
DATE SEP 14 2003

SEP 14 2008

DESCRIPTION

PANEL 8 SCHEDULE 8

DATE _____

09/12/06

JOB # 05365.00

0212_6

E-6.2

[illegible][illegible][illegible][illegible][illegible]